

TOTAL SF AVAILABLE - 3,275 SF


OFFICE - 3,087 SF

WAREHOUSE - 188 SF

[Click to access 3D model](#)



Key Plan

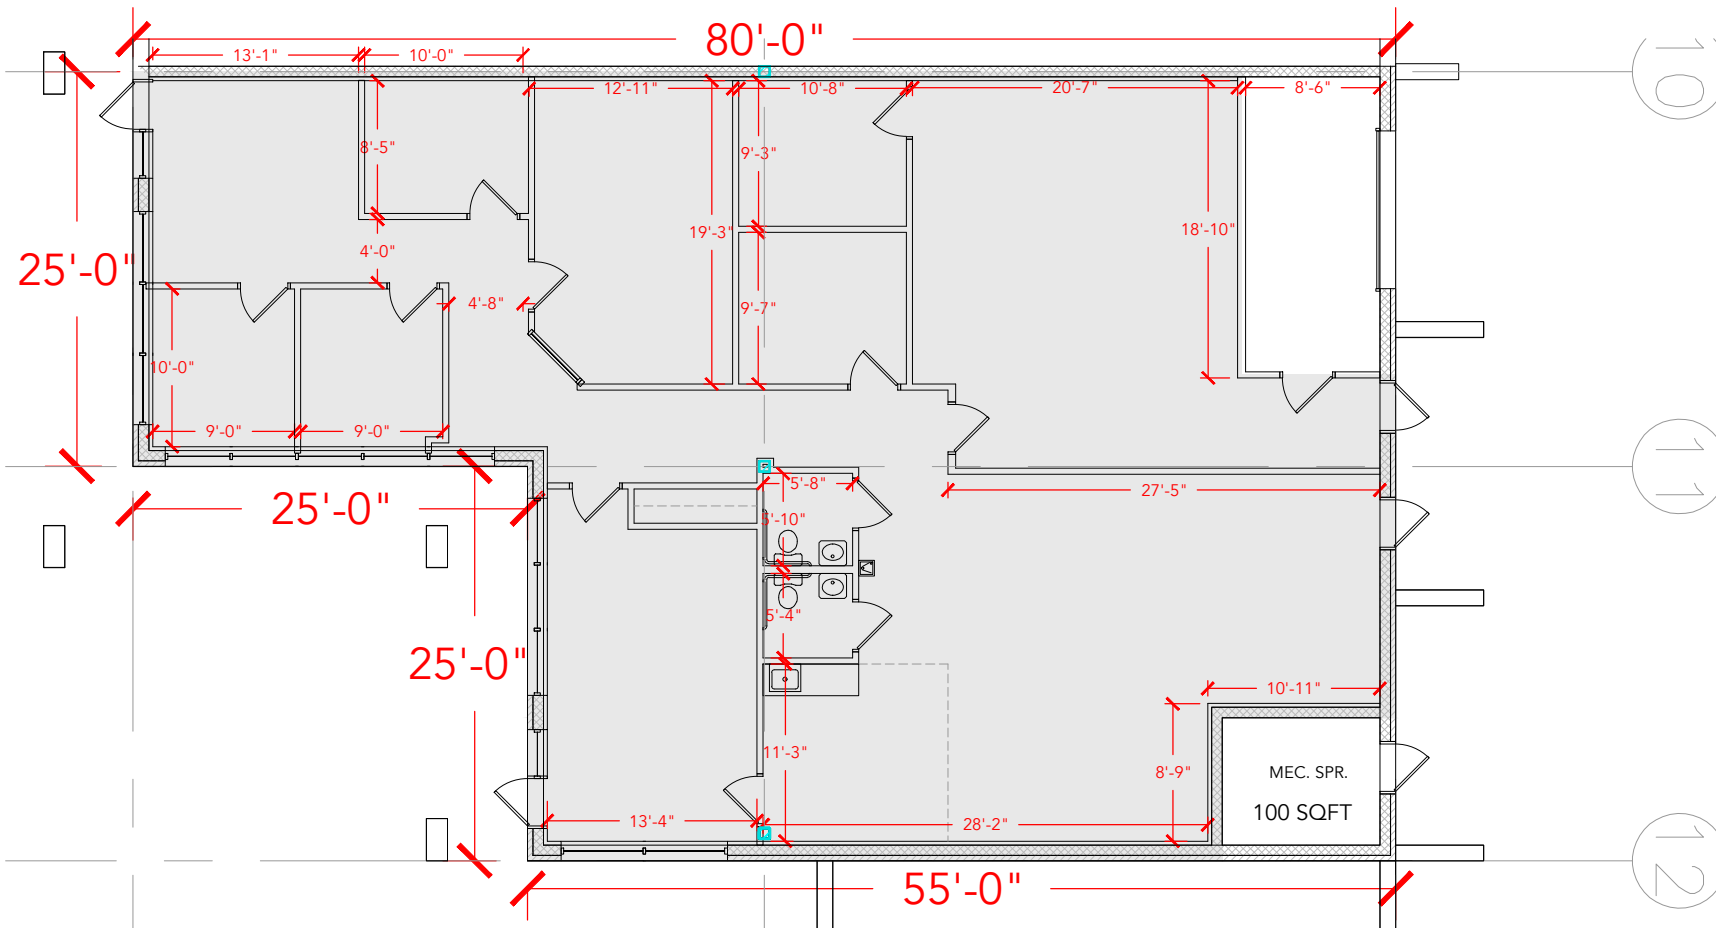

Floor Plan