


TOTAL SF AVAILABLE - 6,000 SF

OFFICE - 6,000 SF


WAREHOUSE - 0,000 SF

[Click to access 3D model](#)

LOADING

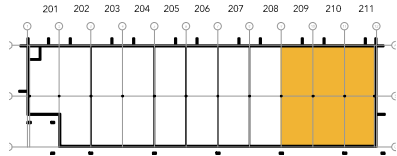

Key Plan

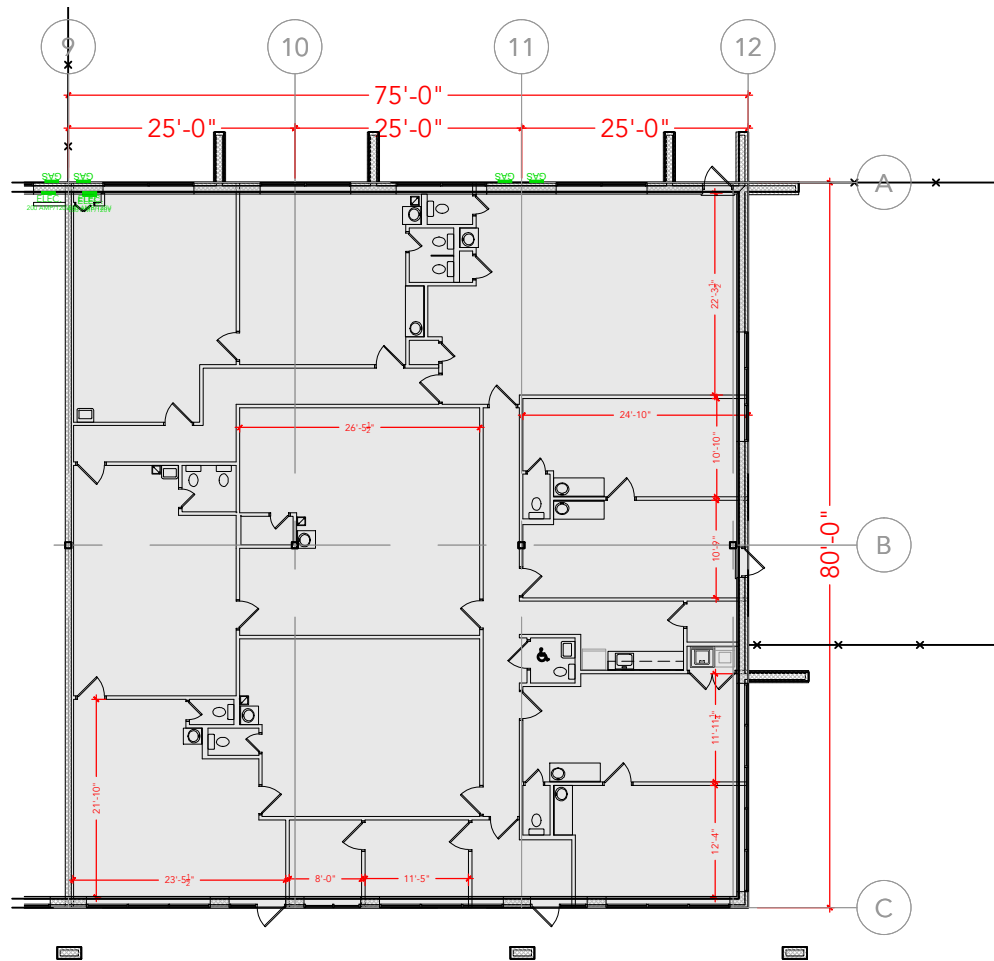

Floor Plan