


**TOTAL SF AVAILABLE -6,000 SF**

OFFICE - 0,000 SF


WAREHOUSE - 6,000 SF

[Click to access 3D model](#)

LOADING

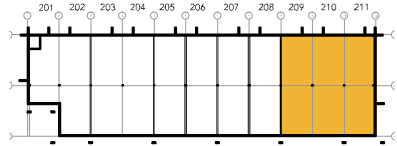

Key Plan

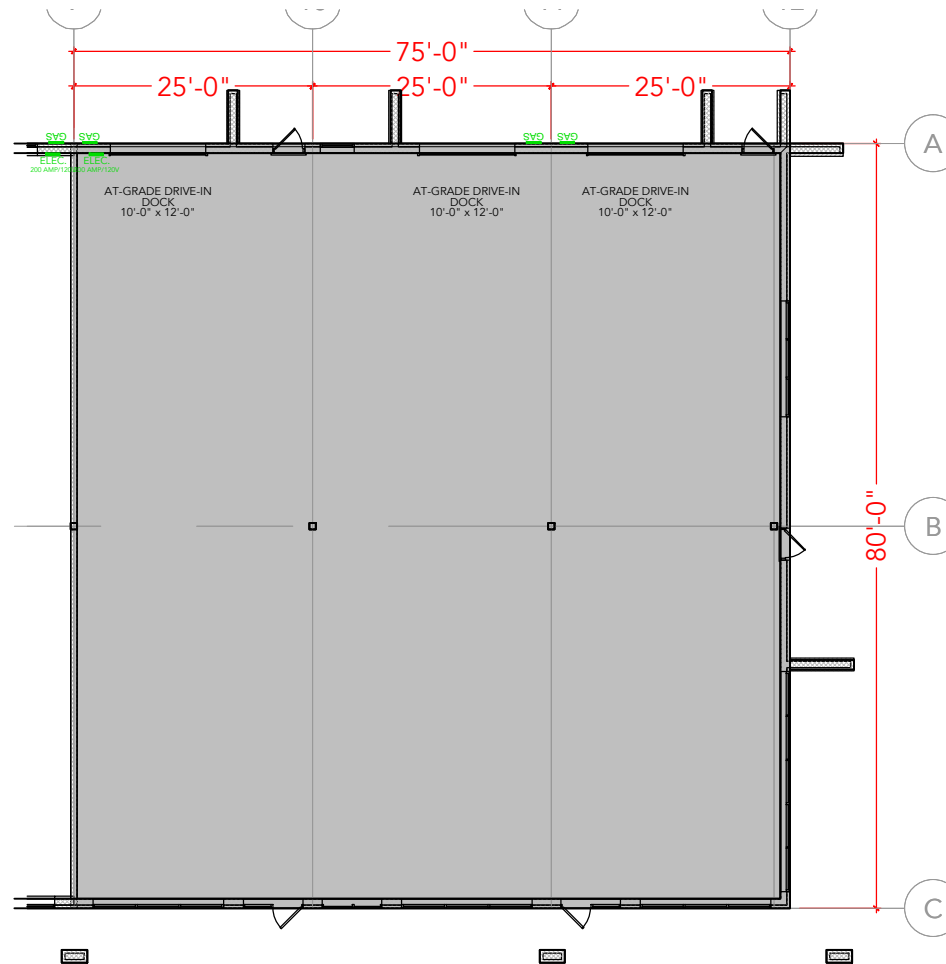

## Floor Plan