


TOTAL SF AVAILABLE - 9,450 SF


OFFICE SF - 3,394 SF

WAREHOUSE SF - 6,056 SF

[Click to access 3D model](#)

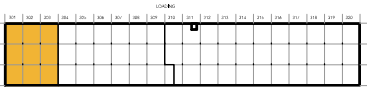

Key Plan

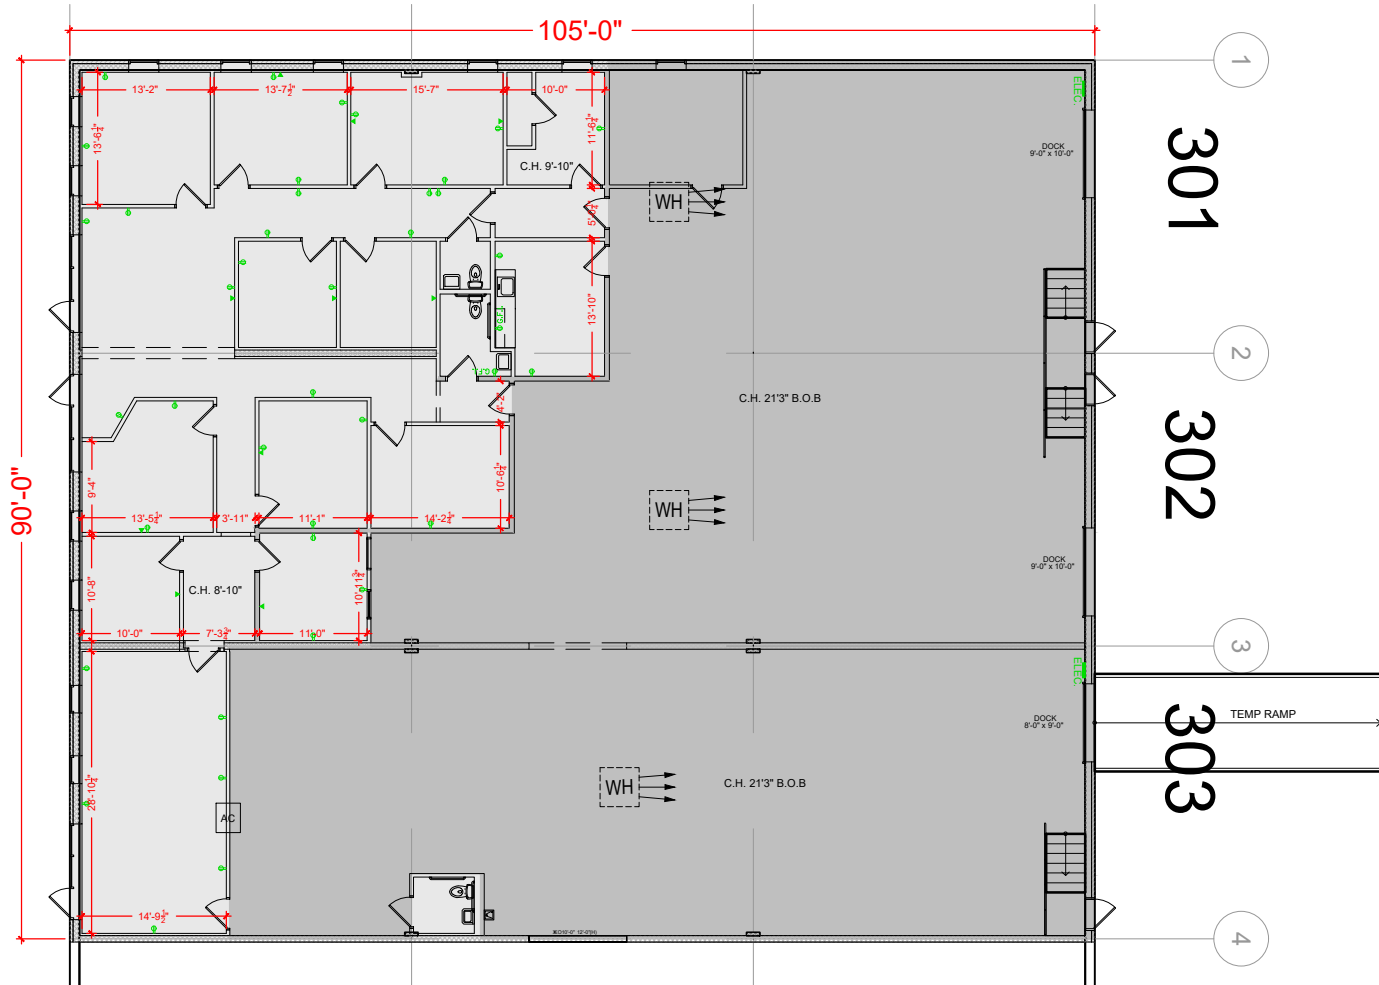

Floor Plan