



TOTAL SF AVAILABLE -19,440 SF

OFFICE - 545

WAREHOUSE SF - 18,895 SF

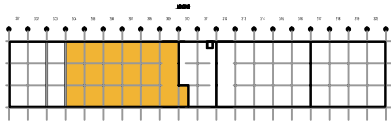

Key Plan

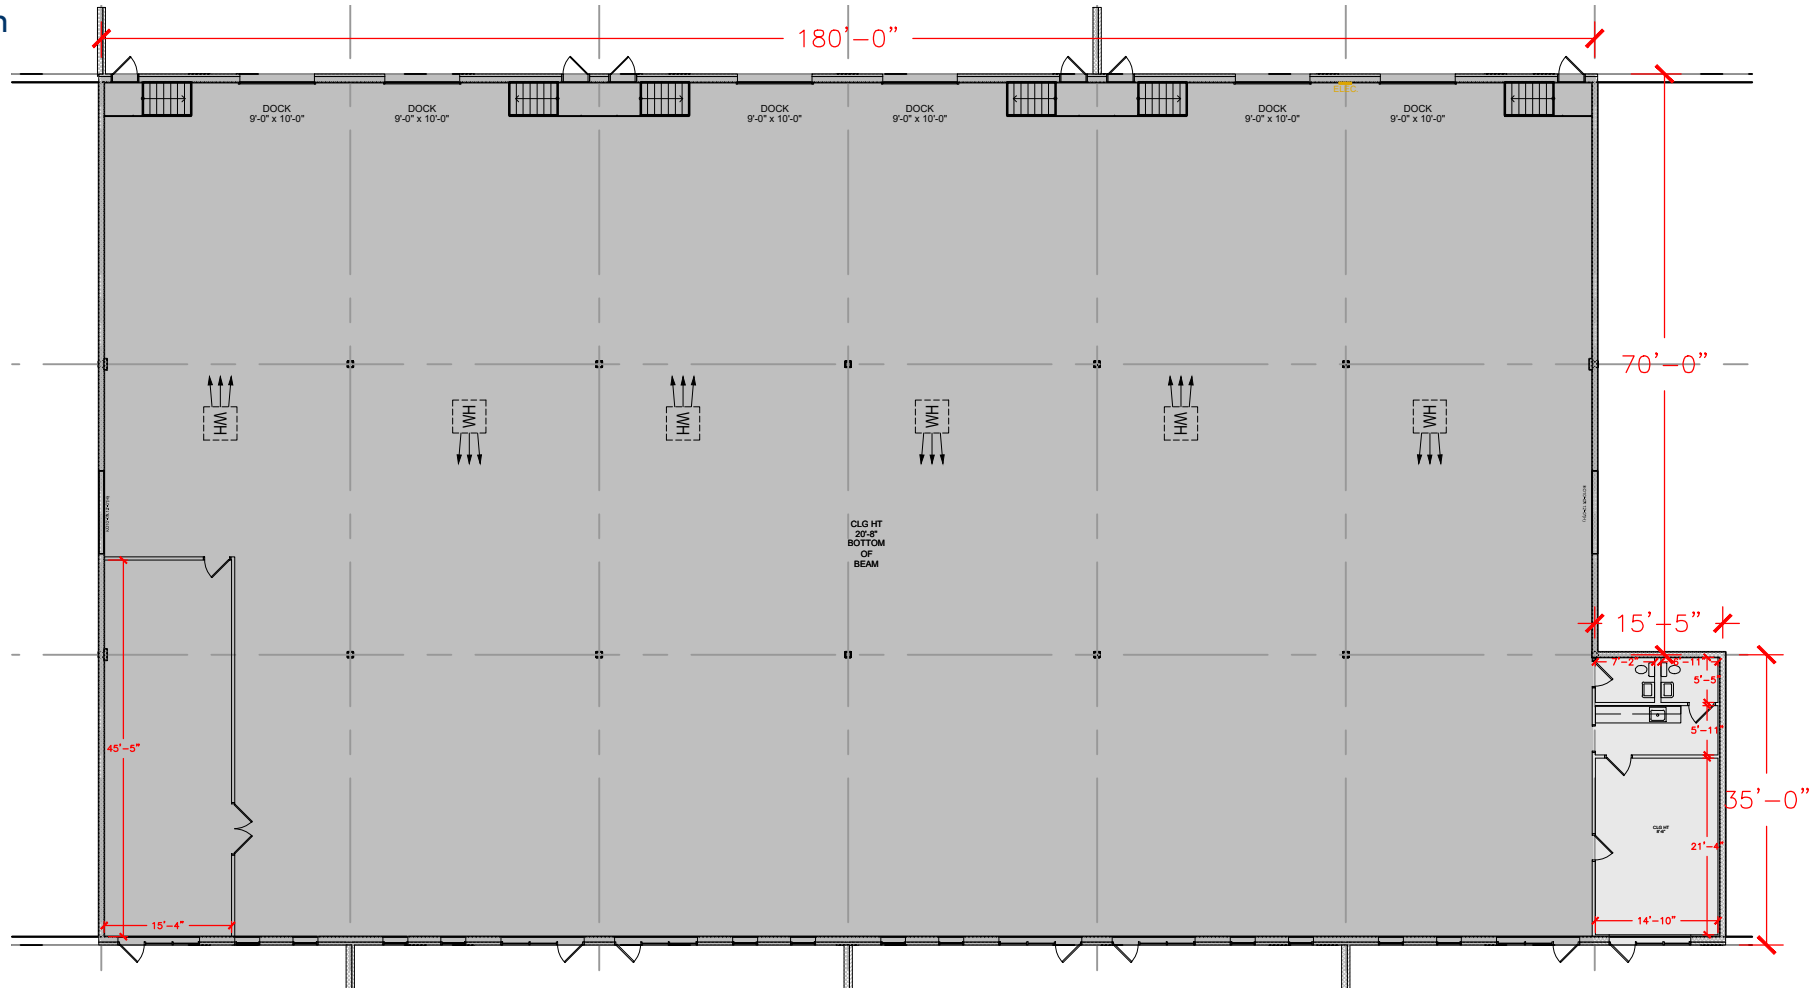

Floor Plan