


**TOTAL SF AVAILABLE - 5,675 SF**

**OFFICE - 832 SF**

**WAREHOUSE - 4,843 SF**

[Click to access 3D model](#)

Key Plan

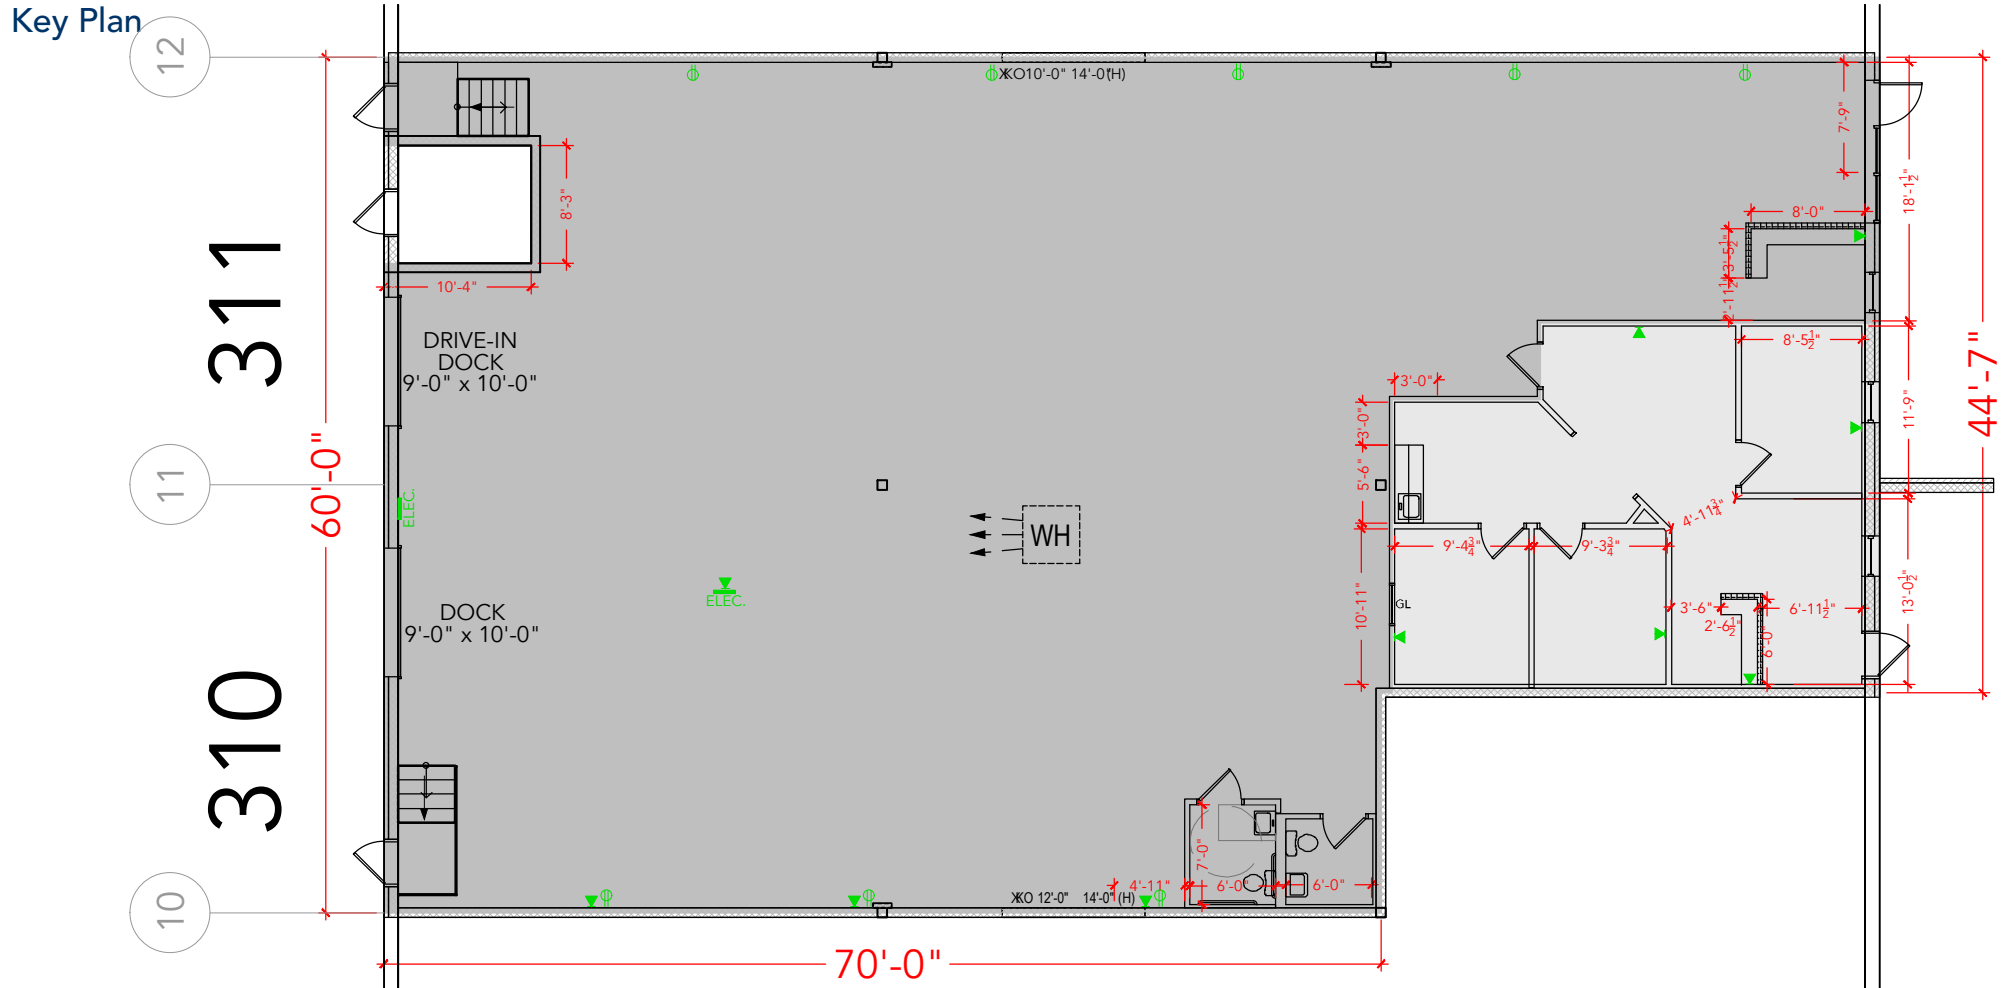

**Floor Plan**