


**TOTAL SF AVAILABLE - 5,937 SF**


**OFFICE - 1,705 SF**

**WAREHOUSE - 4,233 SF**

[Click to access 3D model](#)

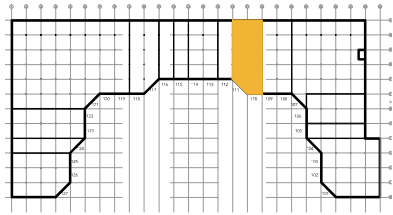

Key Plan

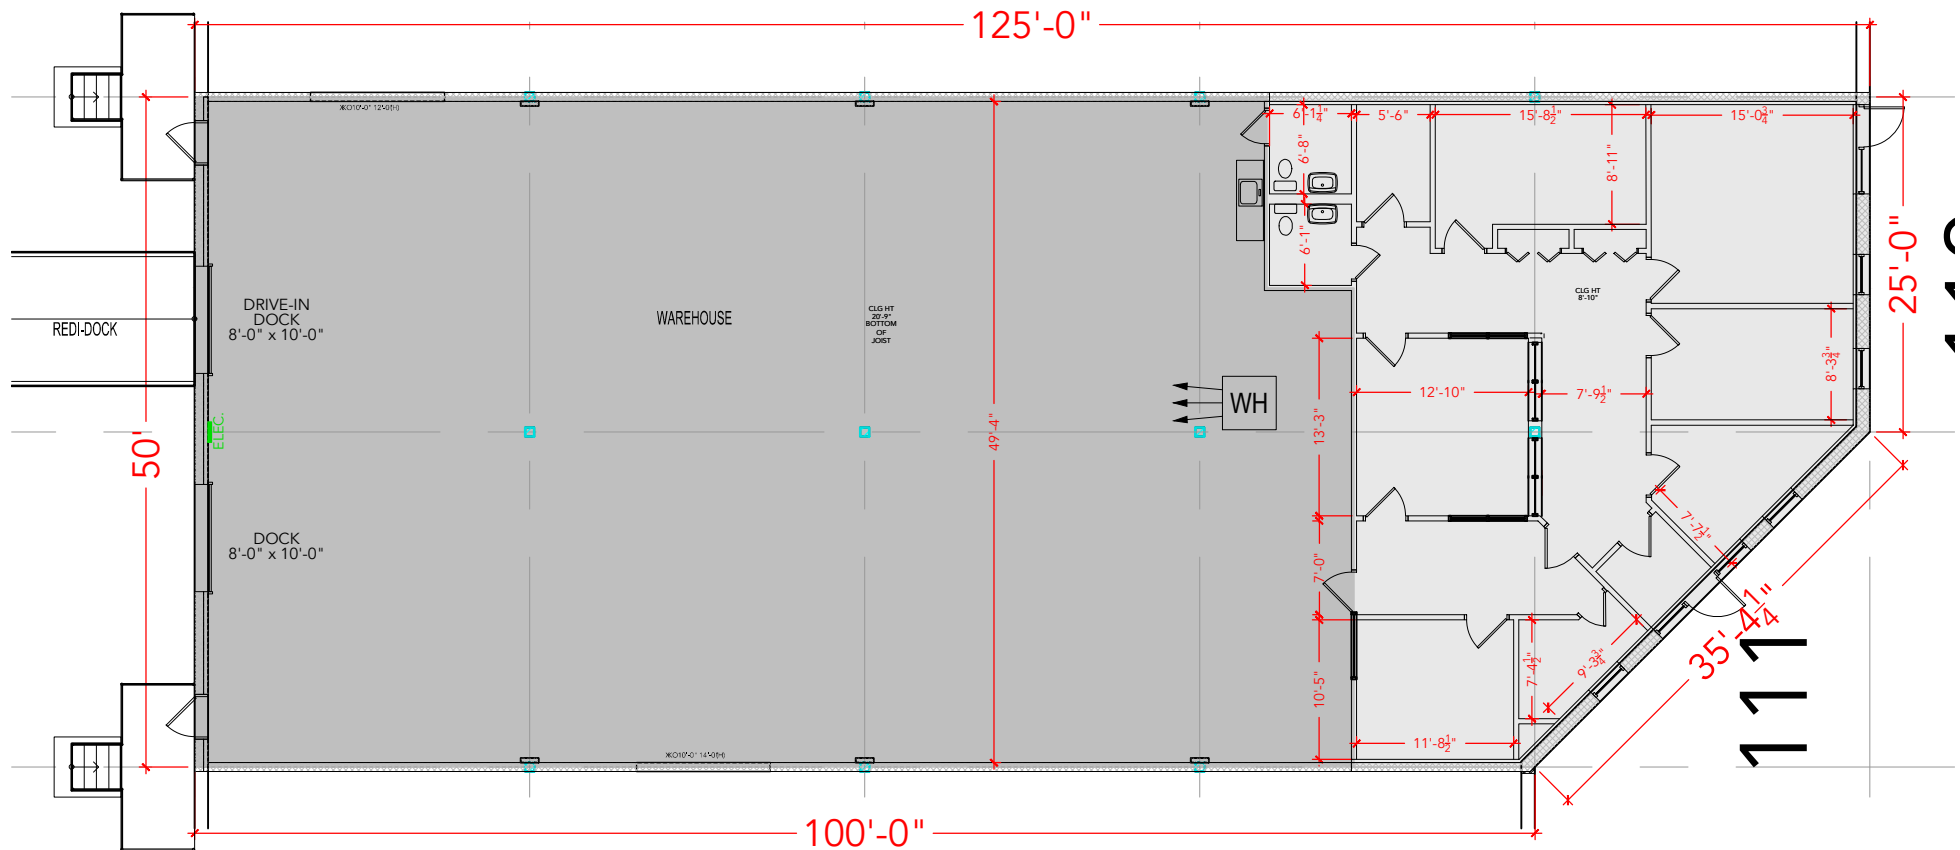

## Floor Plan