


TOTAL SF AVAILABLE - 6,737 SF


OFFICE - 0,000 SF

WAREHOUSE - 6,737 SF

[Click to access CADD file](#)

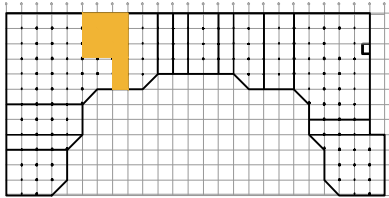

Key Plan

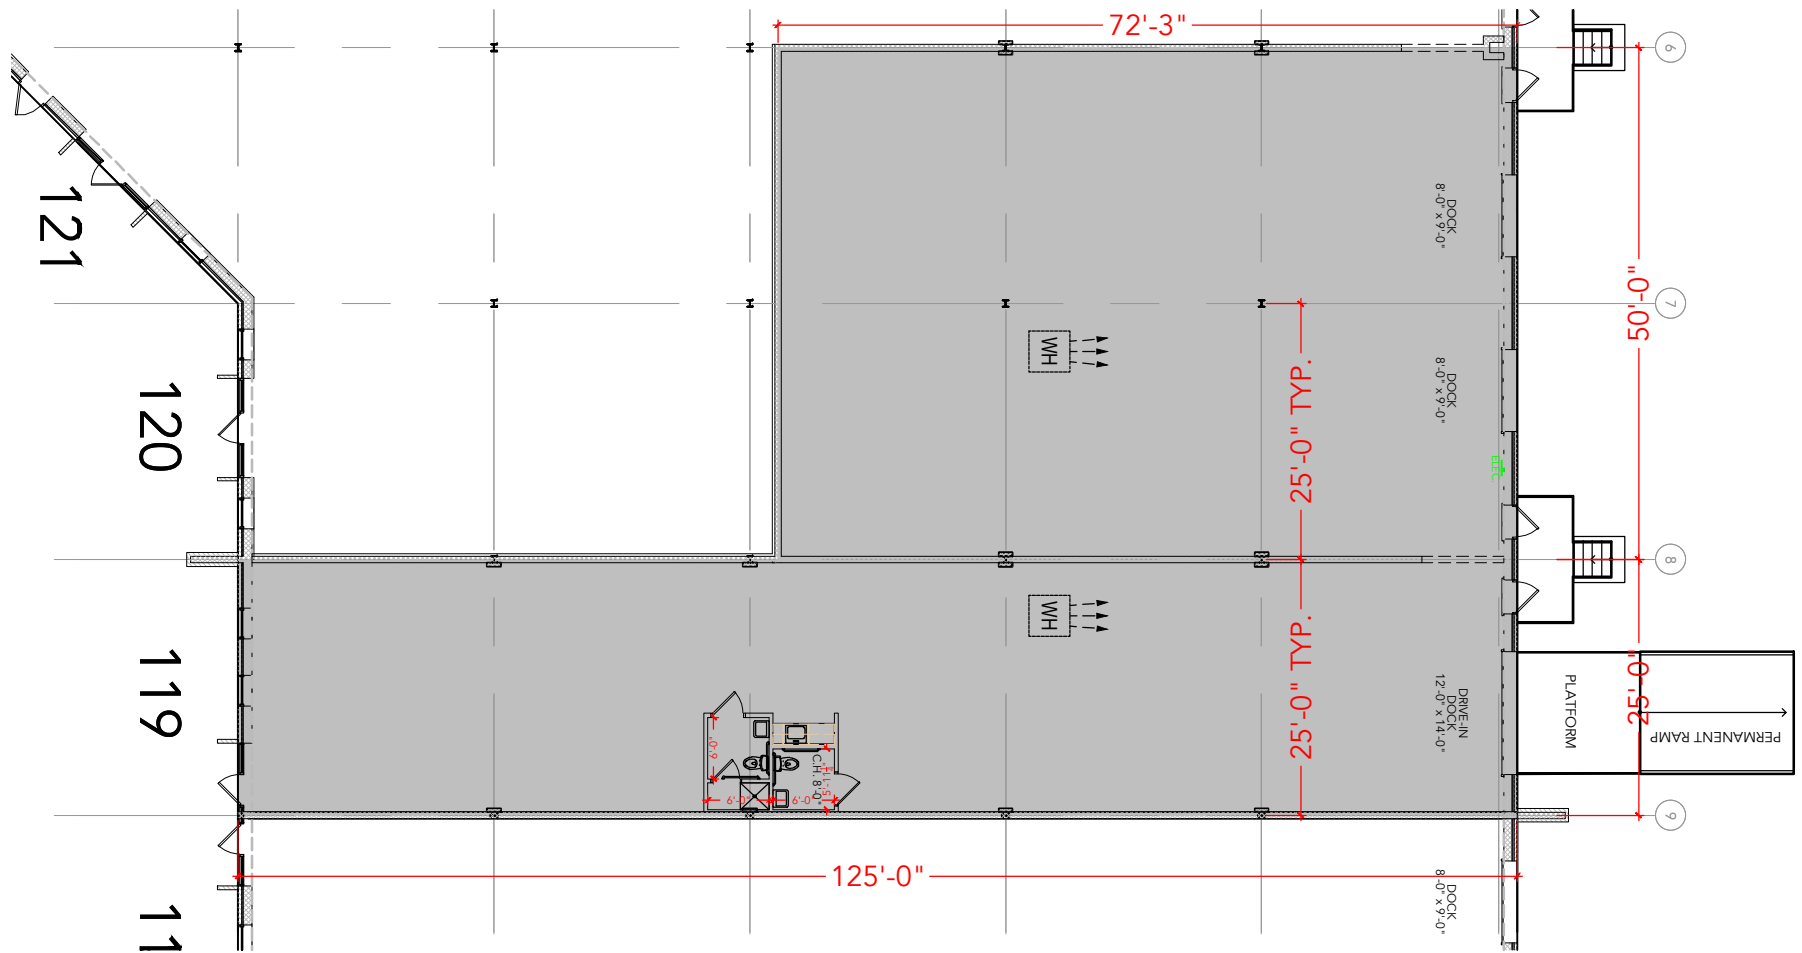

Floor Plan