


**TOTAL SF AVAILABLE - 28,437 SF**

OFFICE - 6,179 SF


WAREHOUSE - 22,258 SF

\* 5,694 SF MACHINE SHOP

[Click to access 3D model](#)

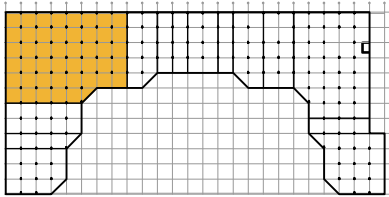

Key Plan

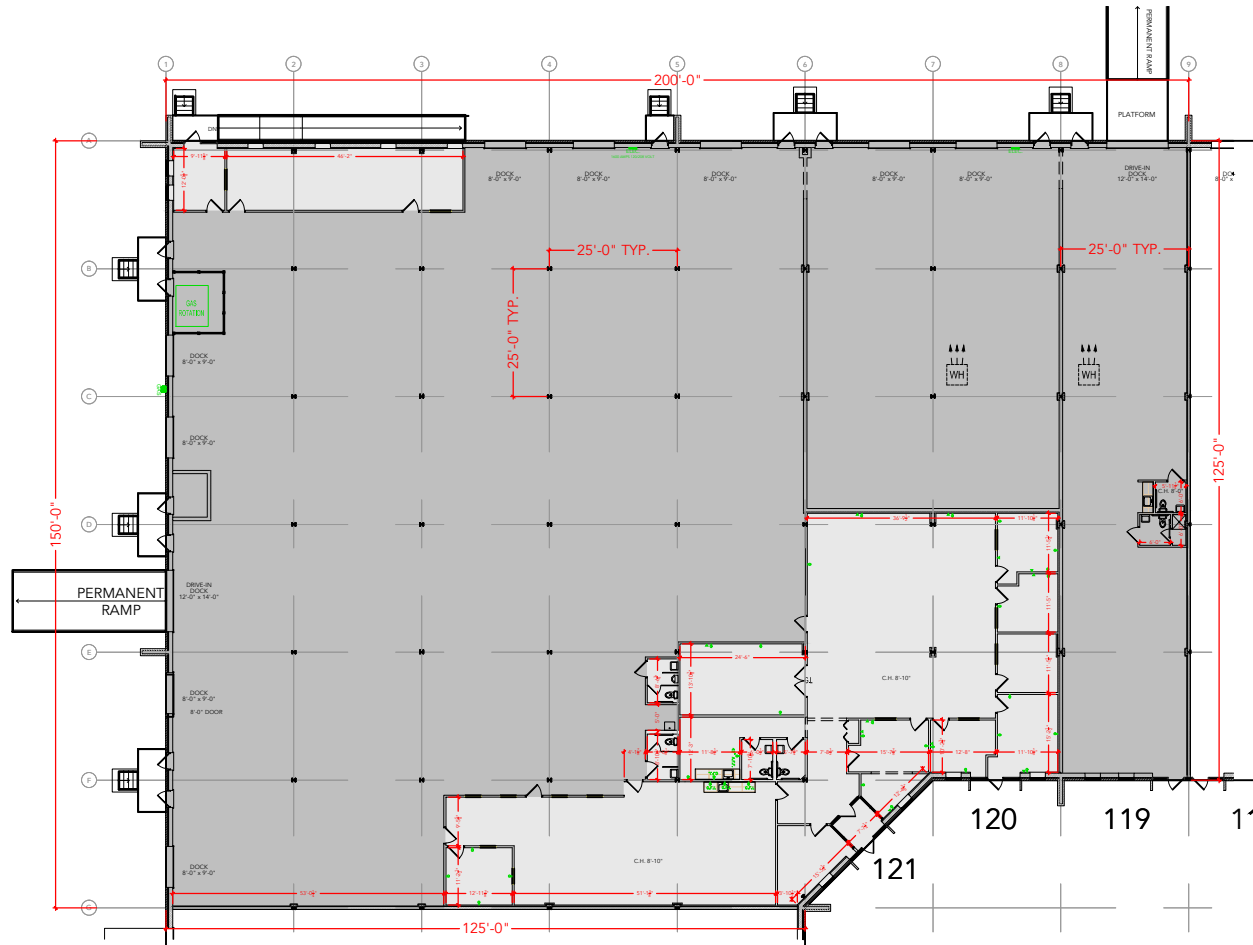

## Floor Plan