


TOTAL SF AVAILABLE - 3,612 SF


OFFICE - 0,000 SF

WAREHOUSE - 3,612 SF

[Click to access 3D model](#)

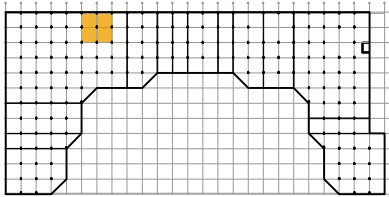

Key Plan

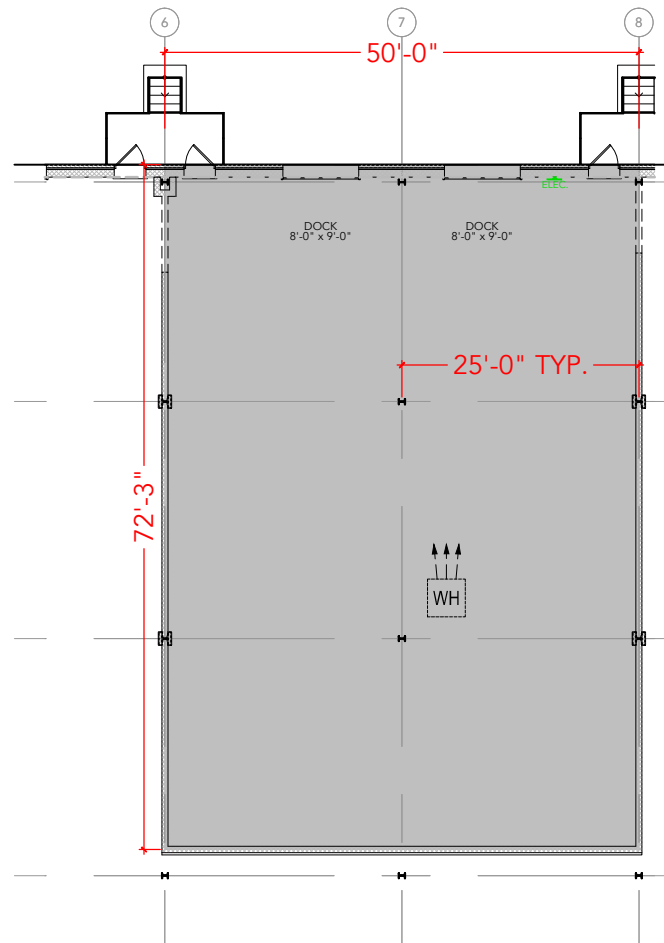

Floor Plan