



TOTAL SF AVAILABLE - 2,700 SF

OFFICE - 1,460 SF
WAREHOUSE SF - 1,240 SF

[Click to access 3D model](#)

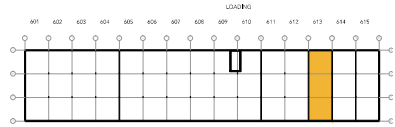

Key Plan

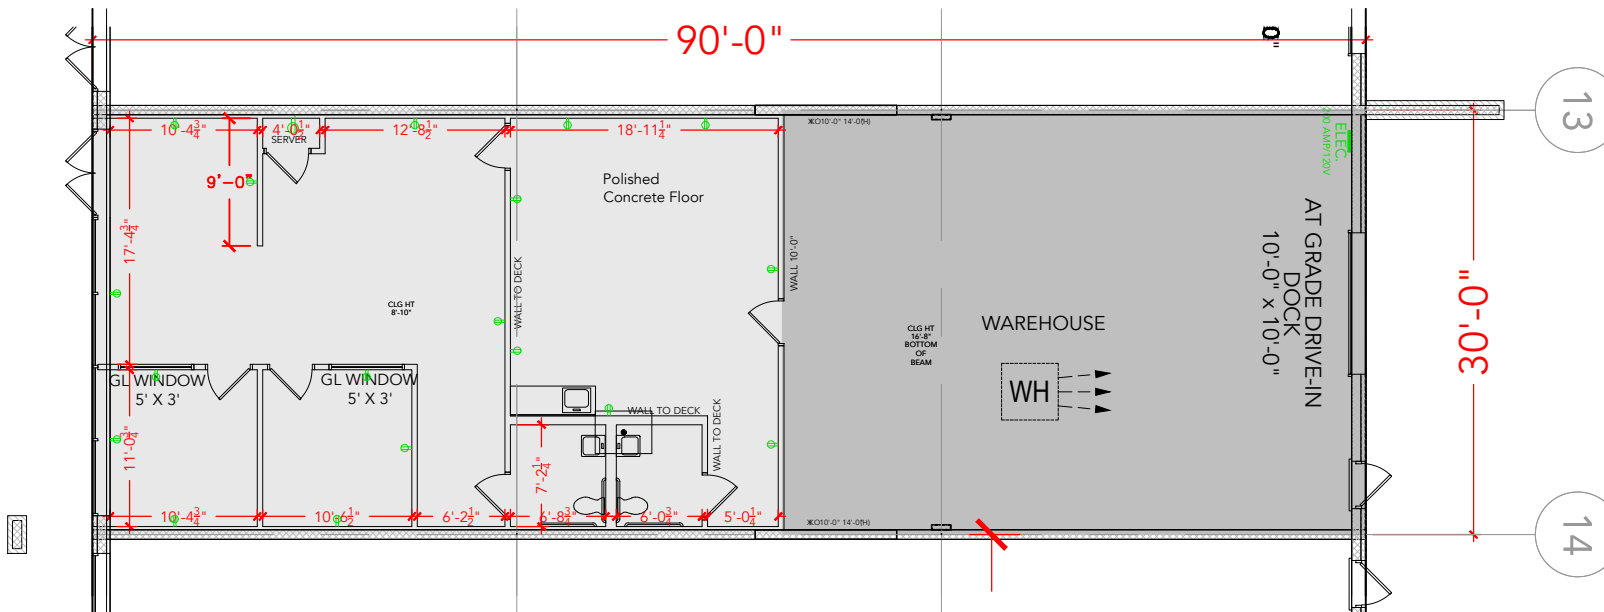

613

Floor Plan