



TOTAL SF AVAILABLE -2,700 SF

OFFICE - 807 SF

WAREHOUSE - 1,893 SF

[Click to access CADD file](#)

Key Plan

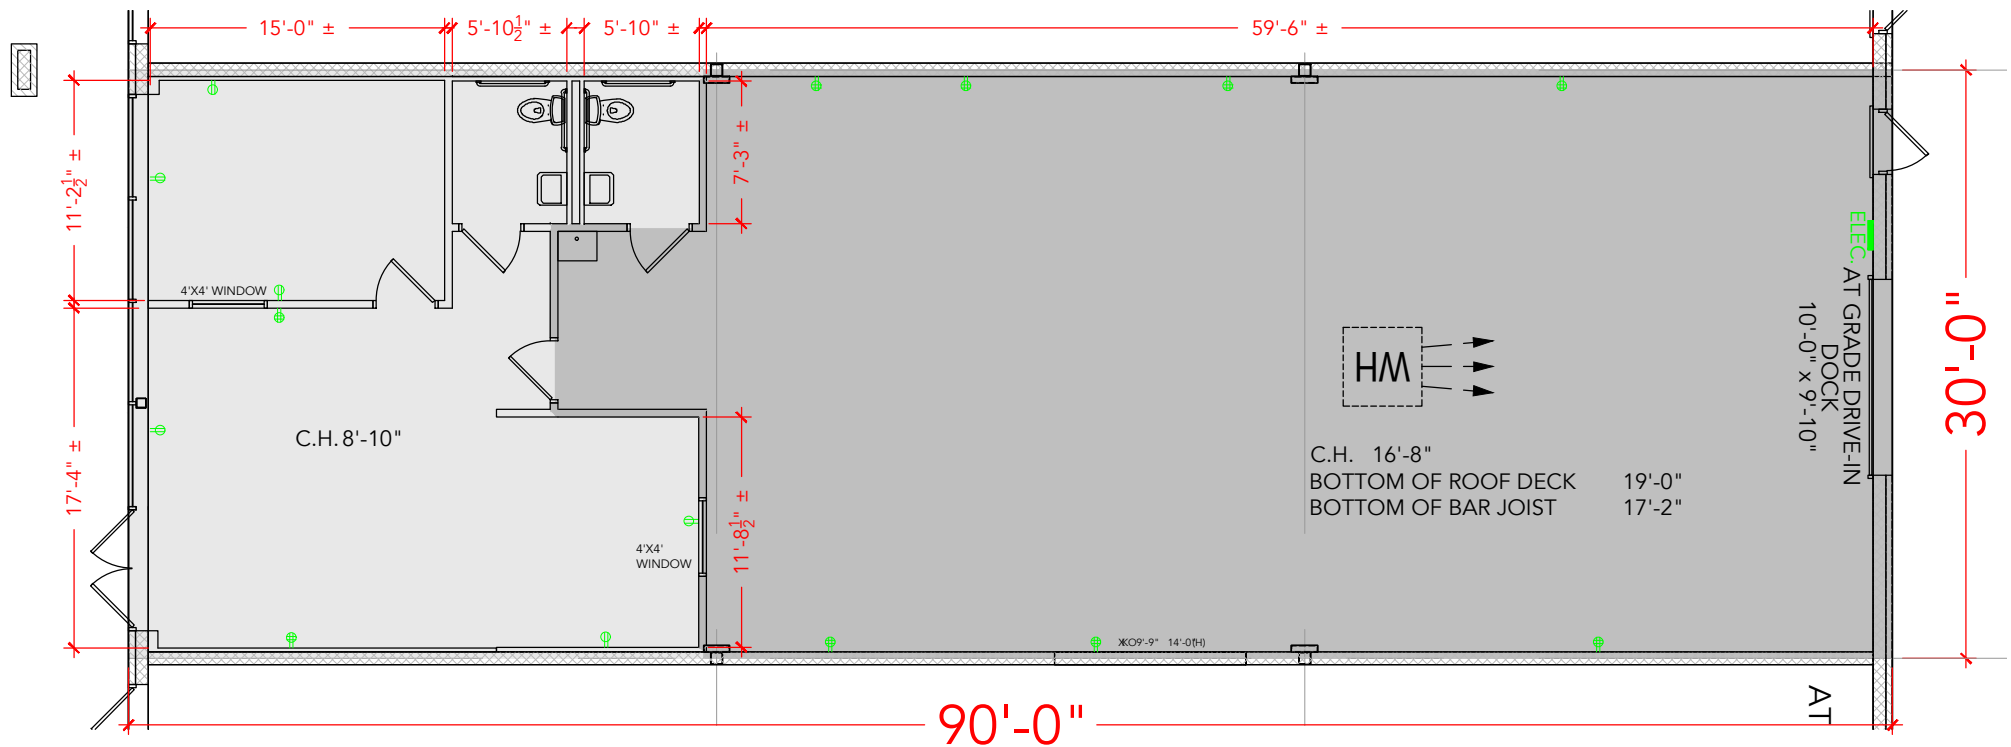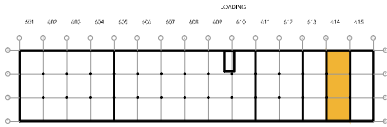

Floor Plan