



TOTAL SF AVAILABLE - 2,550 SF

OFFICE - 842 SF
WAREHOUSE SF - 1,708 SF

[Click to access 3D model](#)

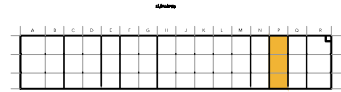

Key Plan

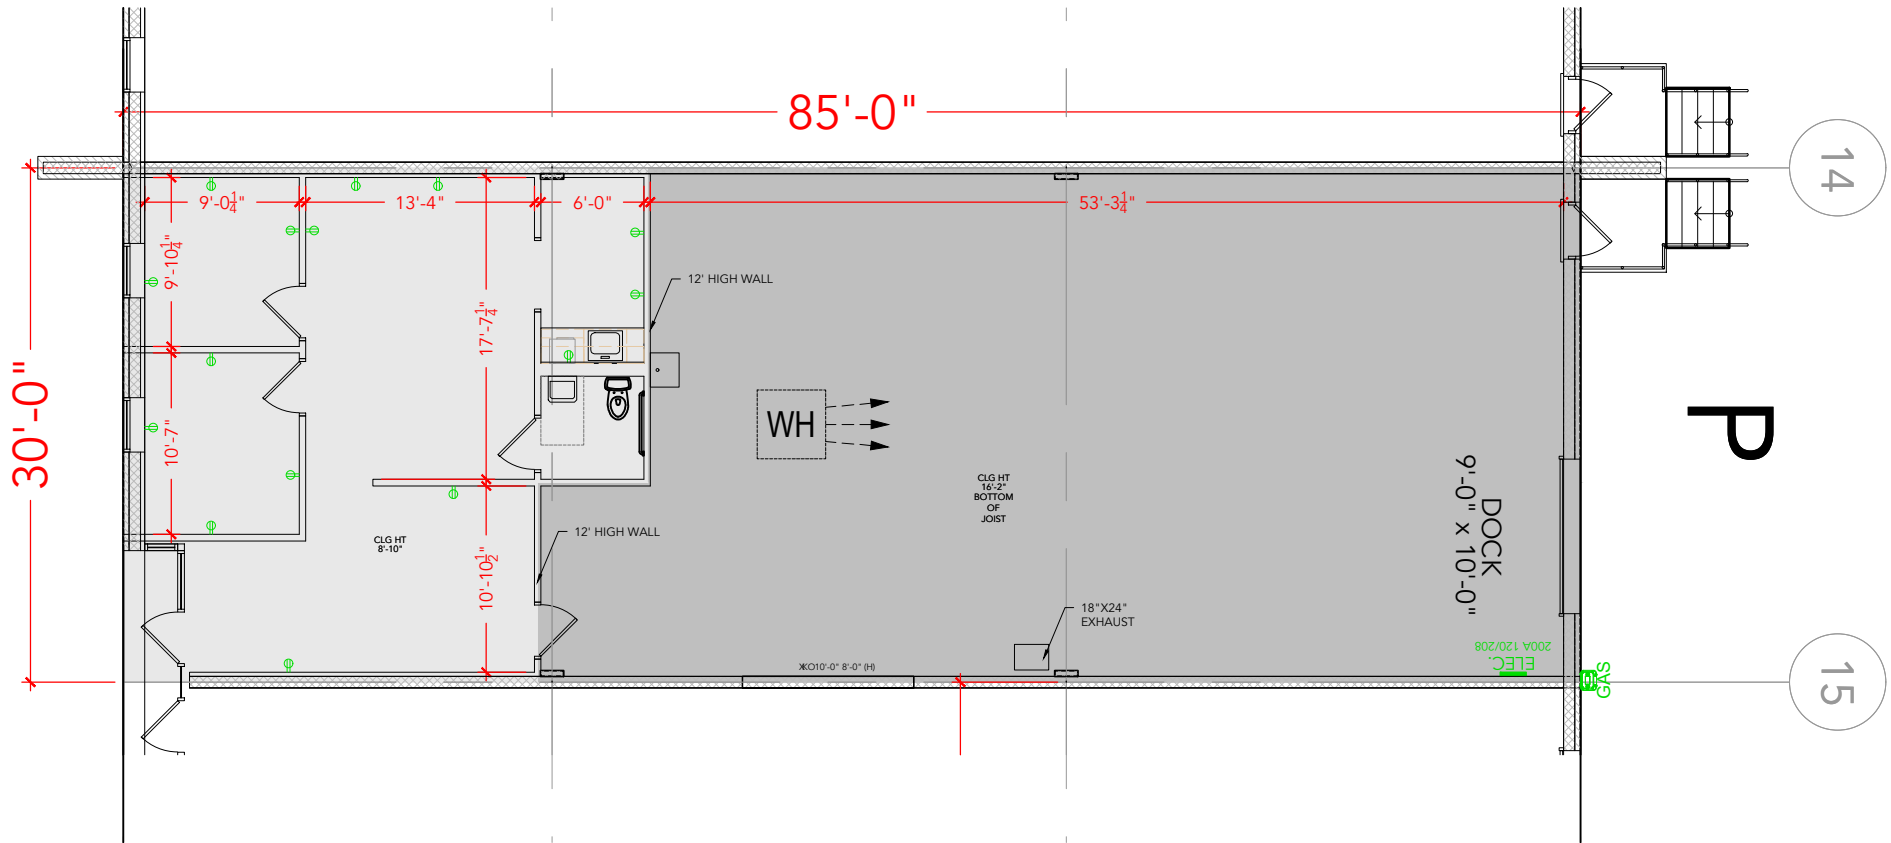

Floor Plan