


TOTAL SF AVAILABLE - 2,550 SF

OFFICE - 842 SF

WAREHOUSE SF - 1,708 SF

[Click to access CADD file](#)

Key Plan

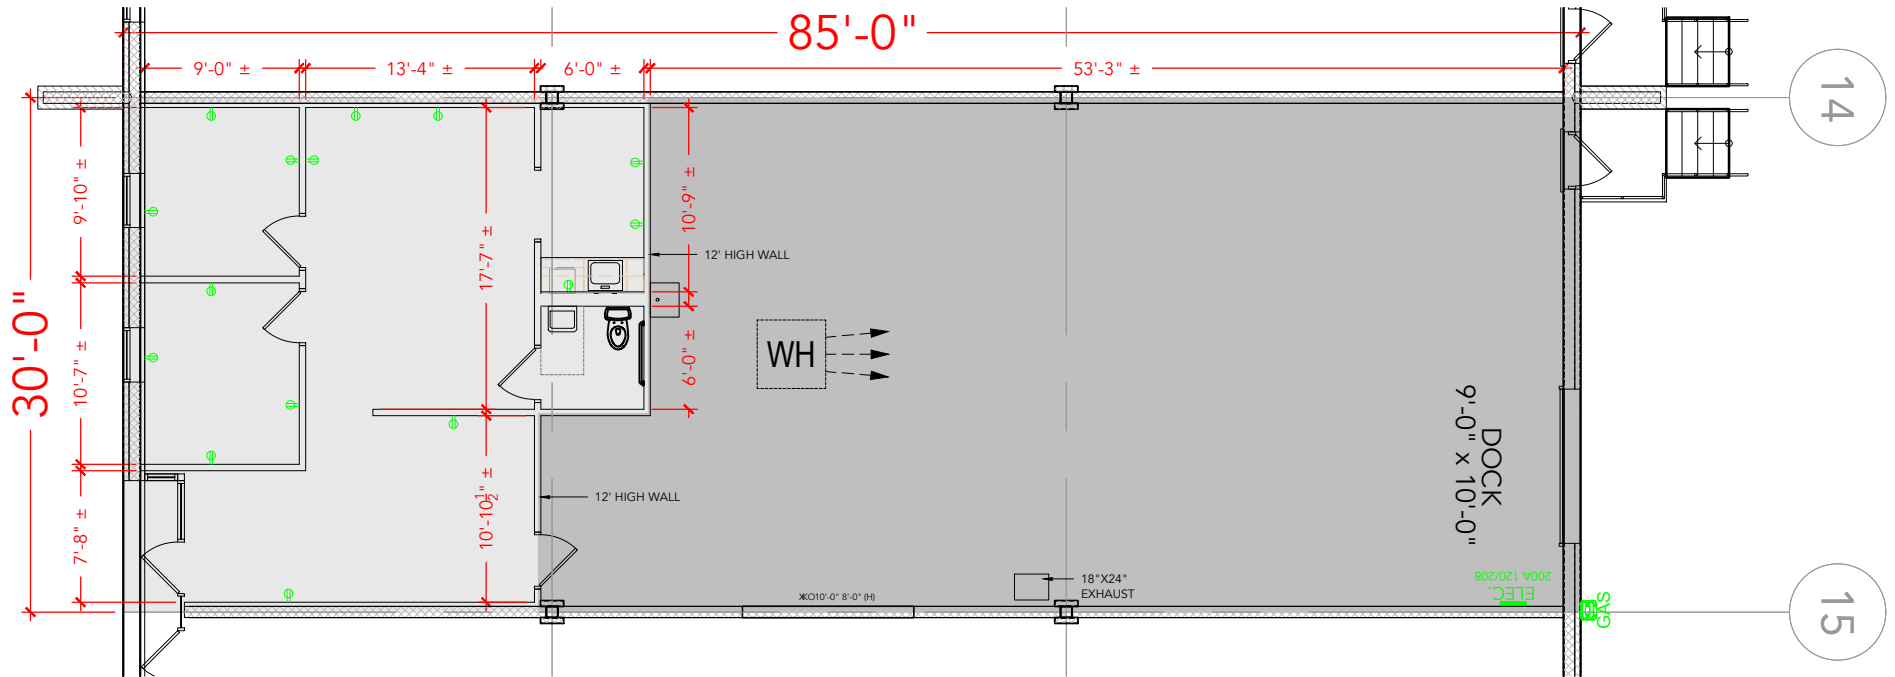

Floor Plan