


TOTAL SF AVAILABLE - 3,323 SF

OFFICE - 1,448 SF
WAREHOUSE - 1,875 SF

[Click to access 3D model](#)

A	B	C	D	E	F	G	H	I	J	K	L	M	N	O	P	Q	R

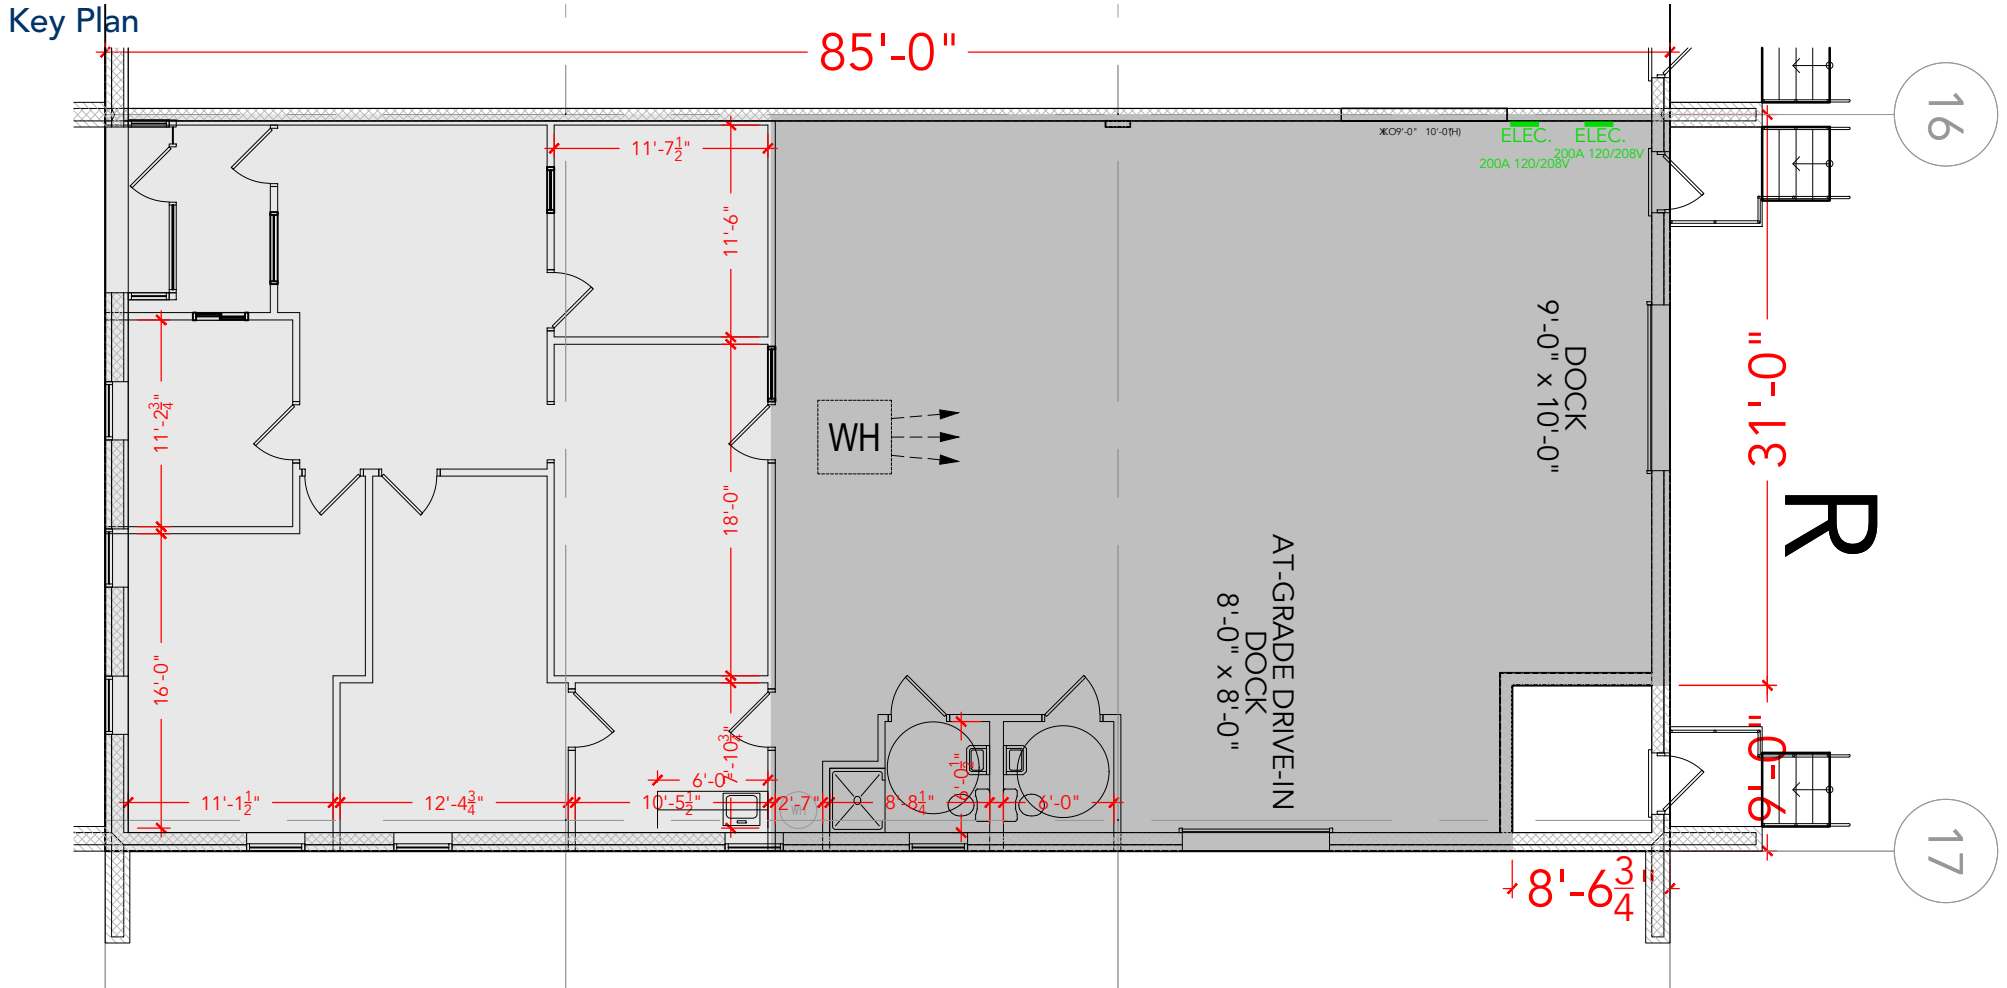

Floor Plan