


TOTAL SF AVAILABLE -3,324 RSF


OFFICE - 1,451 RSF
WAREHOUSE - 1,873 RSF

* INCLUDES % OF METER ROOM

[Click to access CADD file](#)

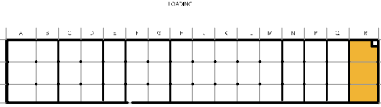

Key Plan

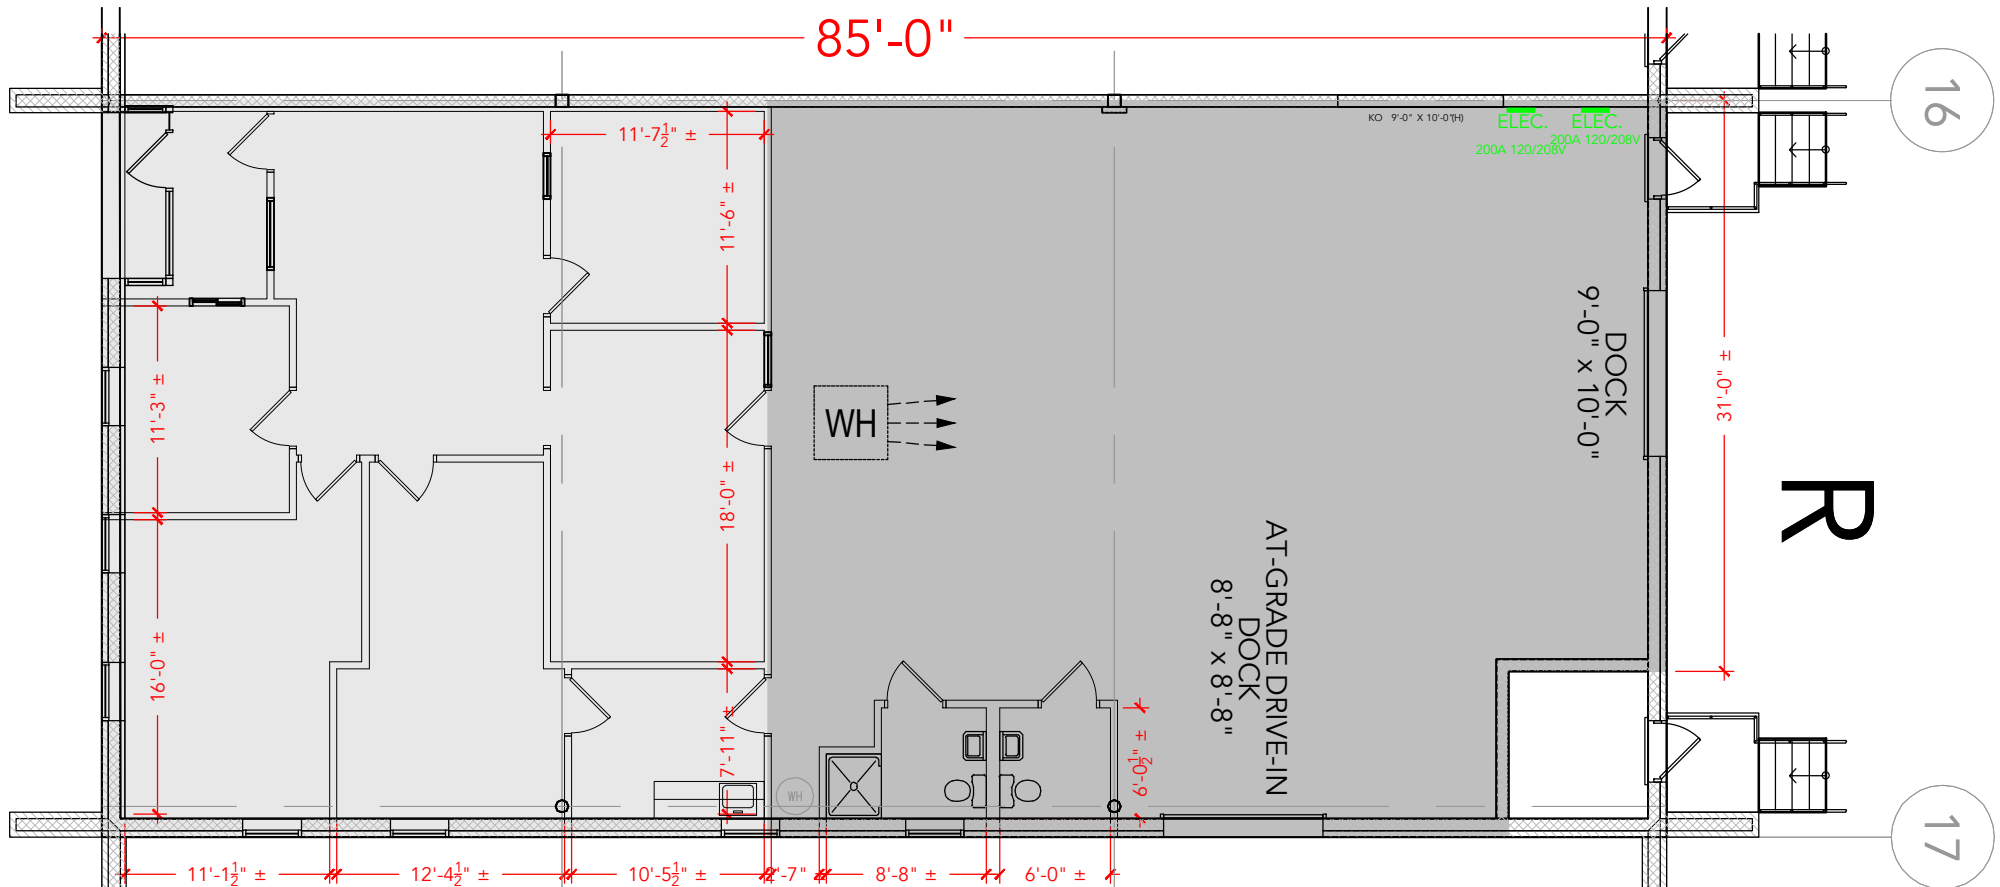

Floor Plan