


TOTAL SF AVAILABLE -3,324 RSF

OFFICE - 1,462 RSF


WAREHOUSE - 1,862 RSF

* INCLUDES % OF METER ROOM

[Click to access CADD file](#)

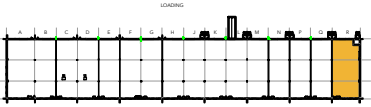

Key Plan

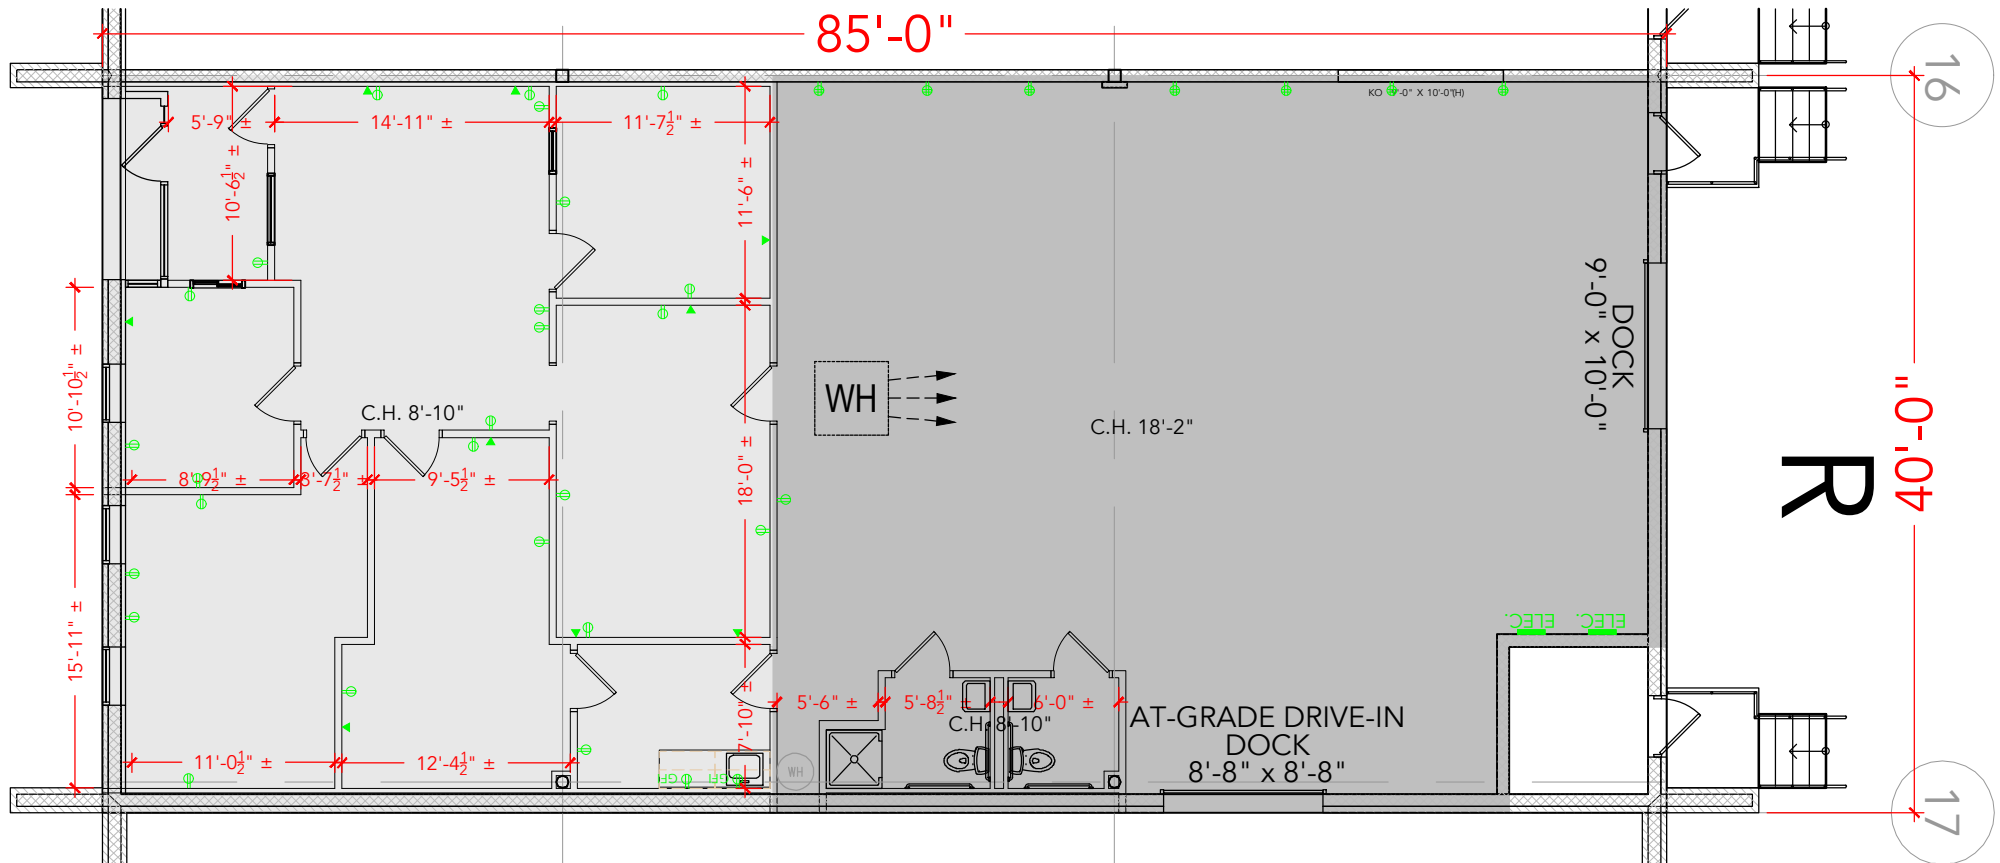

Floor Plan