


TOTAL SF AVAILABLE - 5,100 SF


OFFICE - 1,809 SF

WAREHOUSE - 3,291 SF

[Click to access 3D model](#)

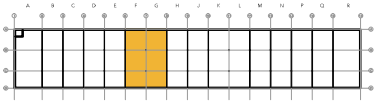

Key Plan

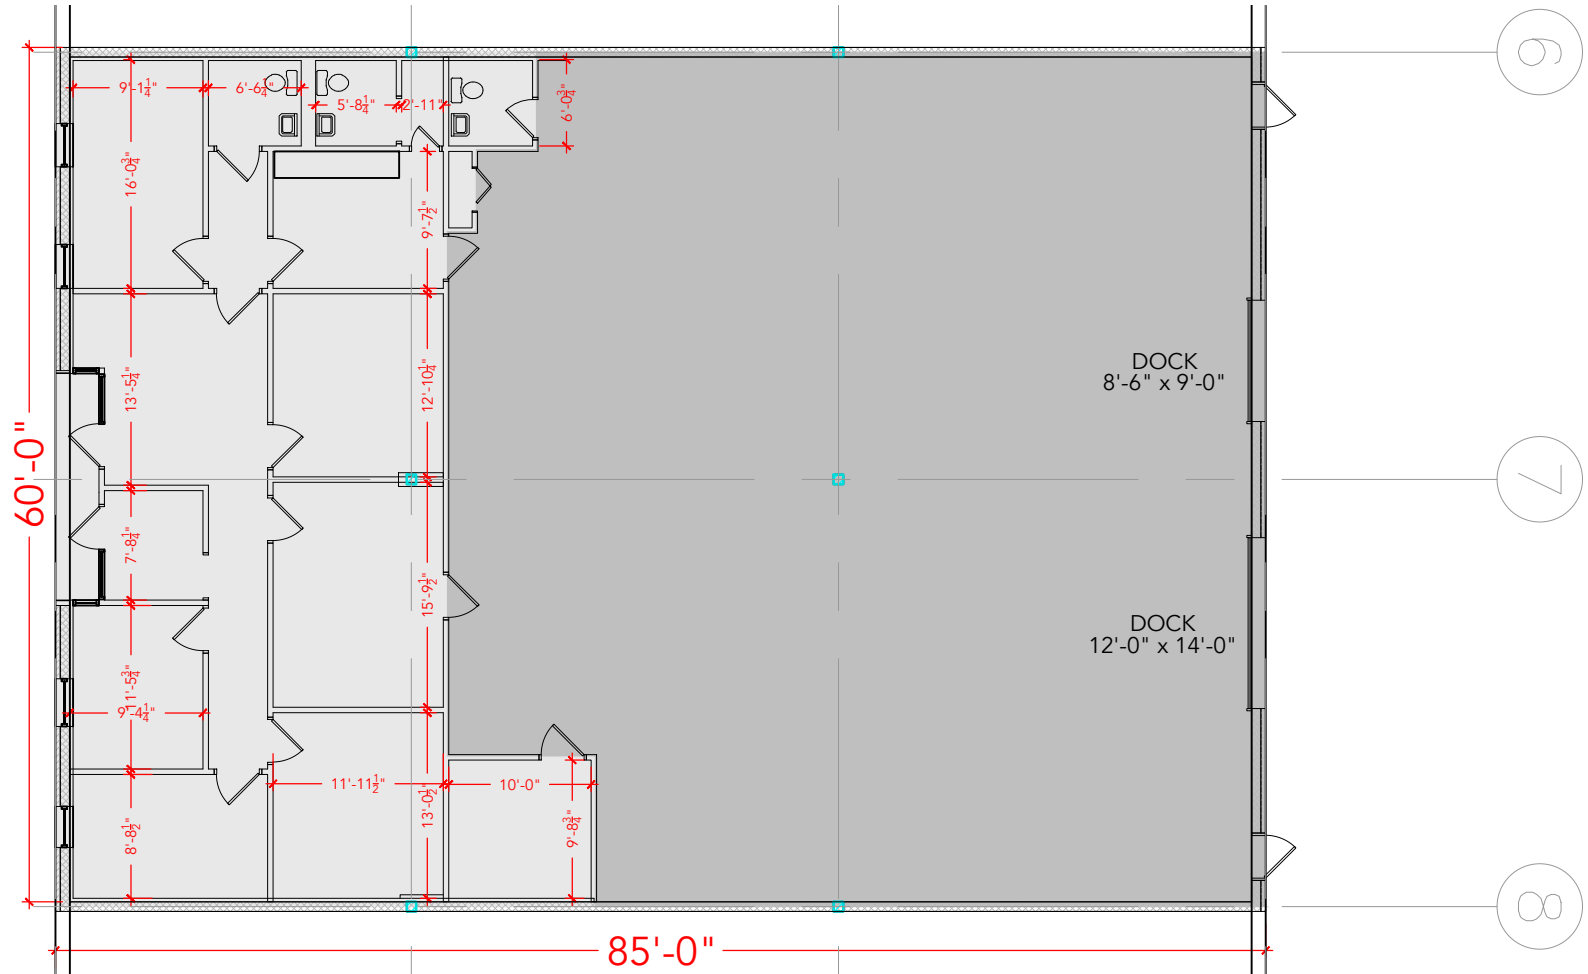

Floor Plan