


TOTAL SF AVAILABLE - 5,100 SF

OFFICE - 1,699 SF
WAREHOUSE - 3,401 SF

[Click to access 3D model](#)



Key Plan

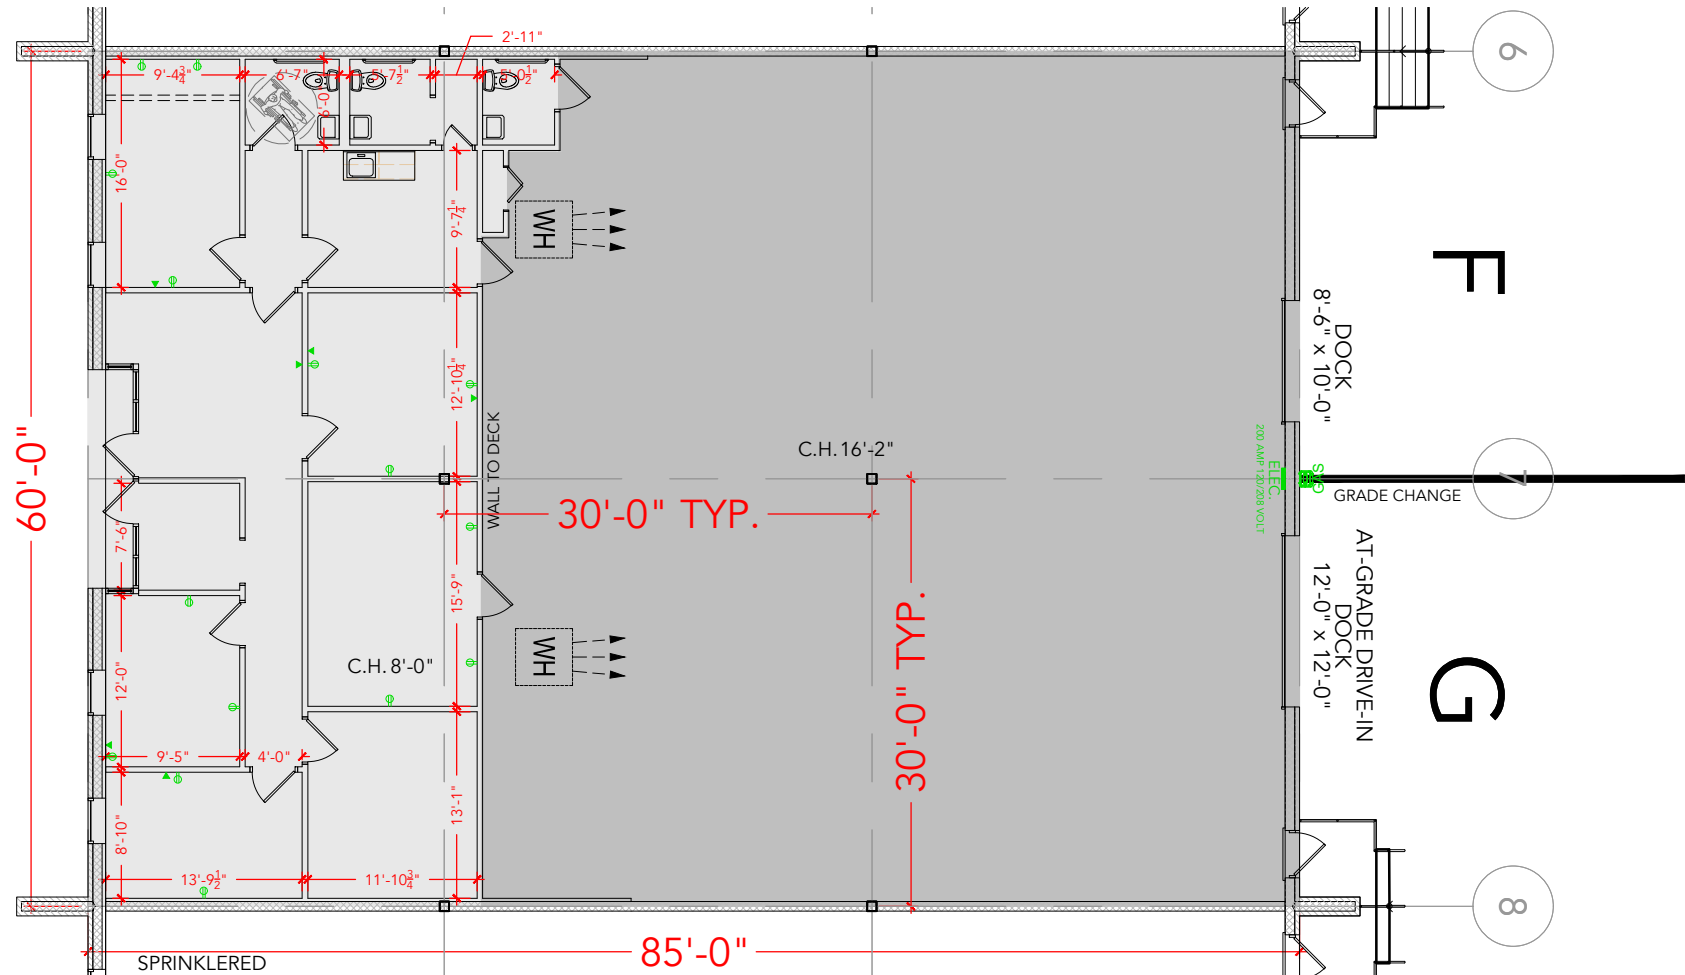

Floor Plan