


TOTAL SF AVAILABLE - 2,550 SF

OFFICE - 1,326 SF
WAREHOUSE - 1,224 SF

[Click to access 3D model](#)

Key Plan

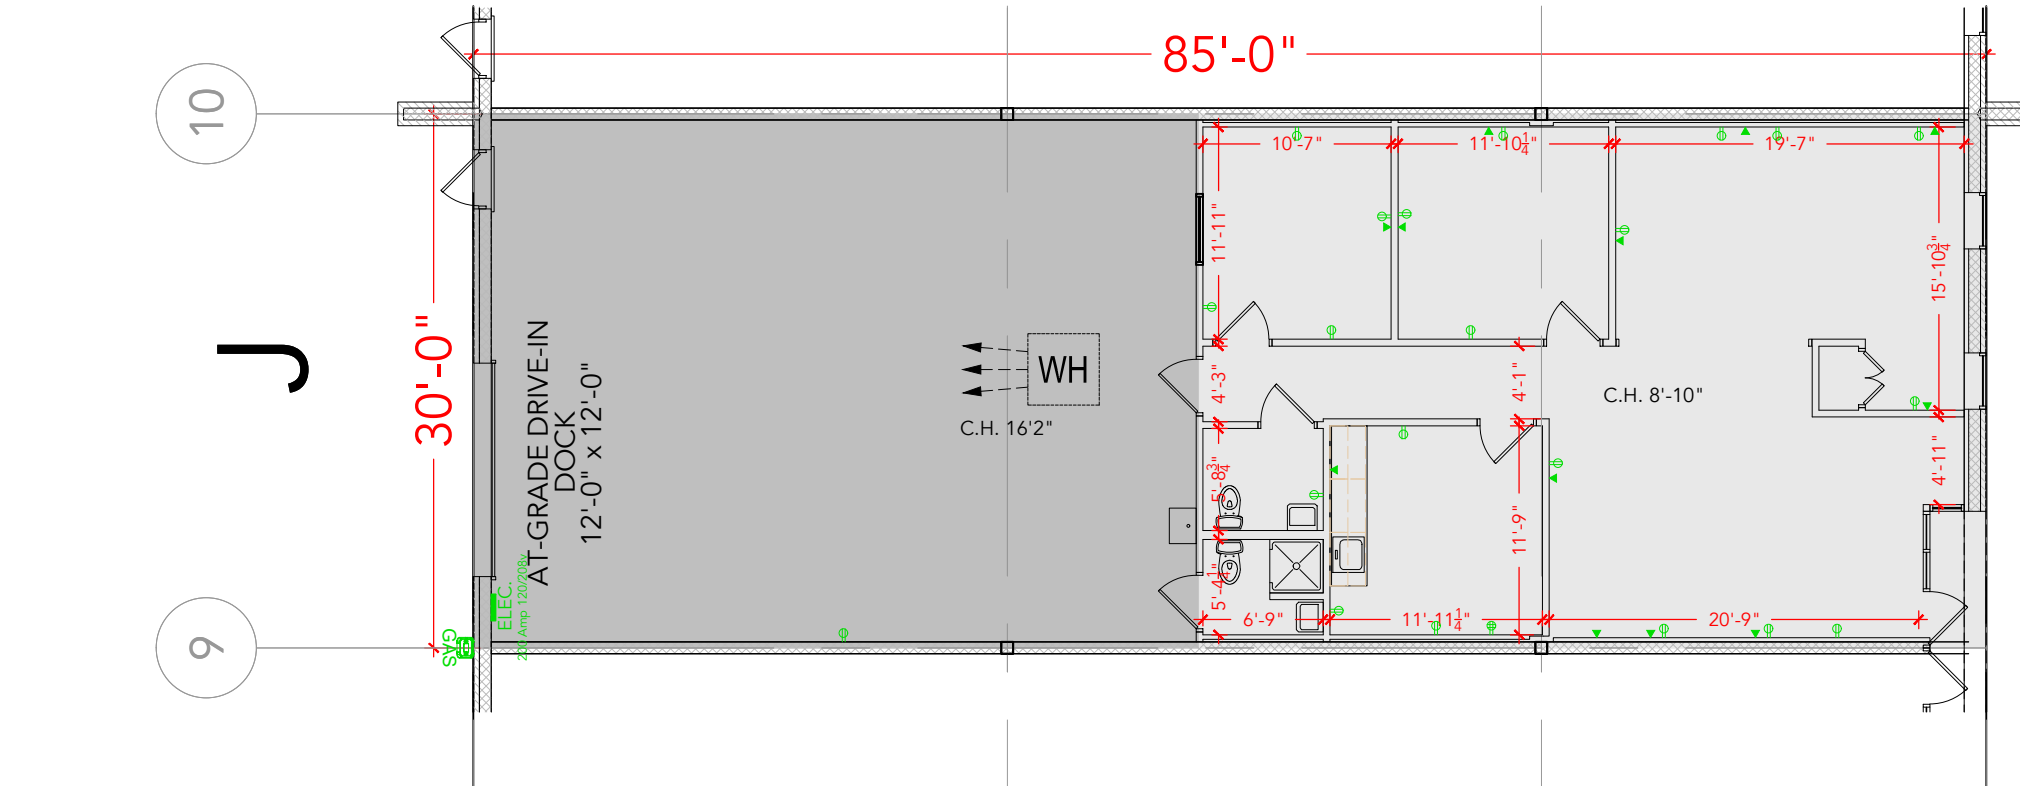

Floor Plan