


**TOTAL SF AVAILABLE -5,114 RSF**

OFFICE - 1,554 RSF


WAREHOUSE - 3,560 RSF

\* INCLUDES % OF METER ROOM

[Click to access CADD file](#)

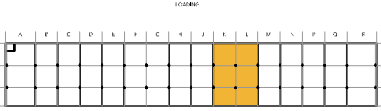

Key Plan

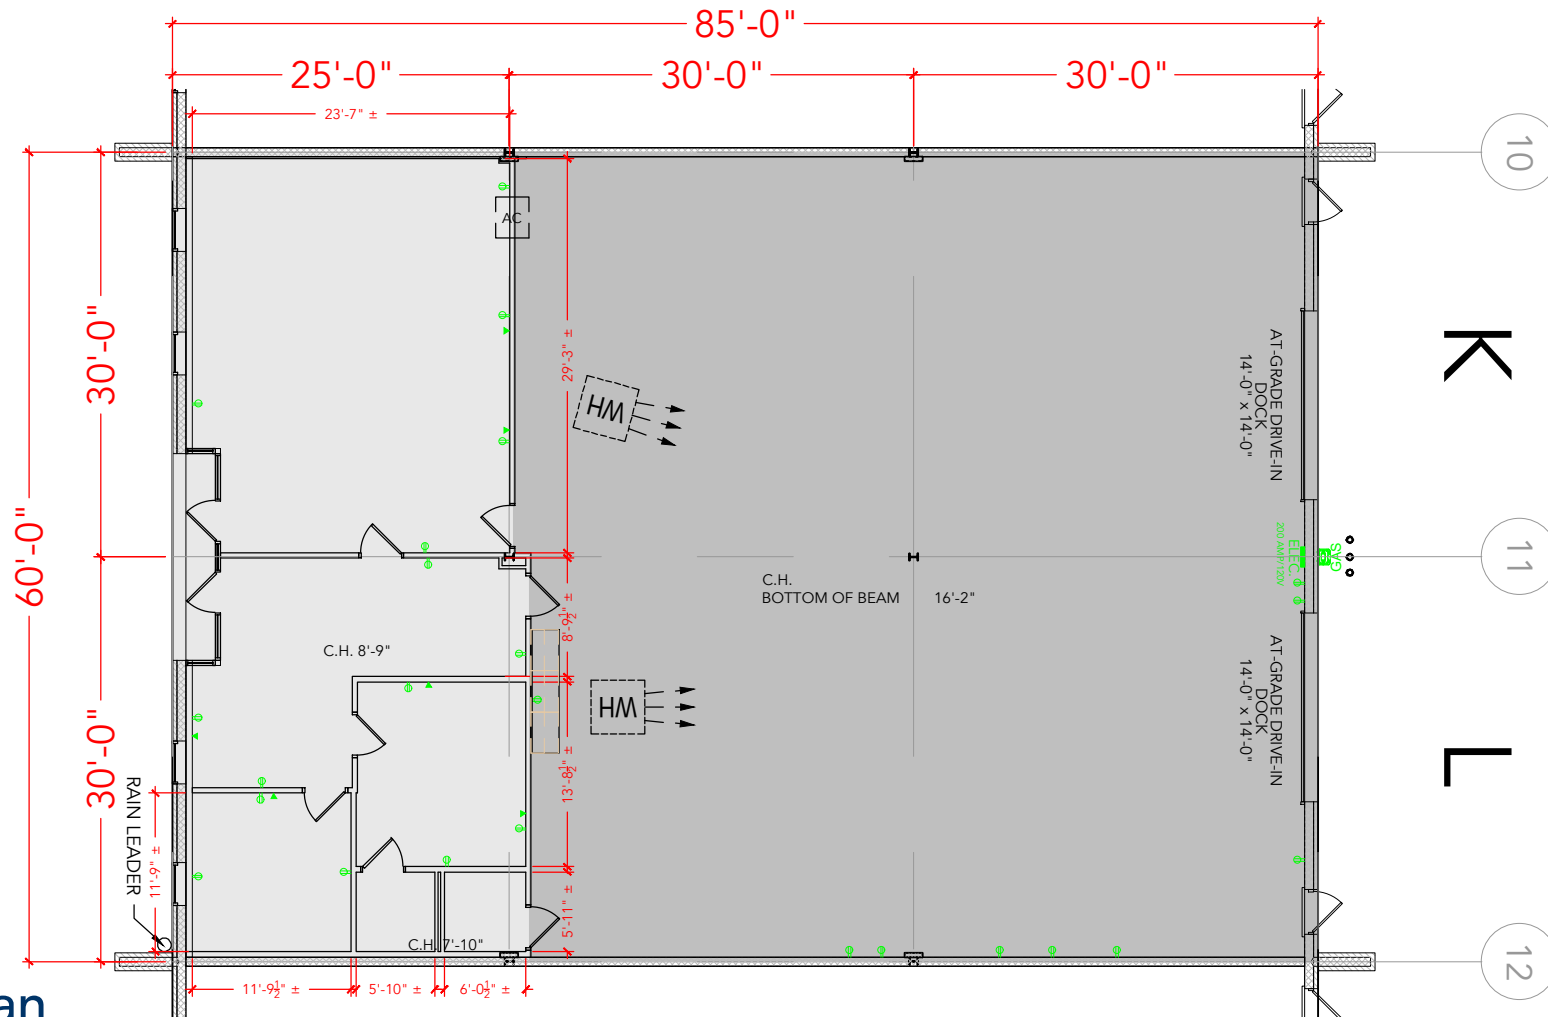

Floor Plan