


TOTAL SF AVAILABLE - 12,500 SF


OFFICE - 499 SF

WAREHOUSE - 12,001 SF

[Click to access 3D model](#)

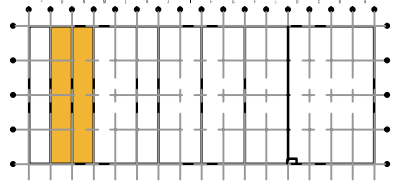

Key Plan

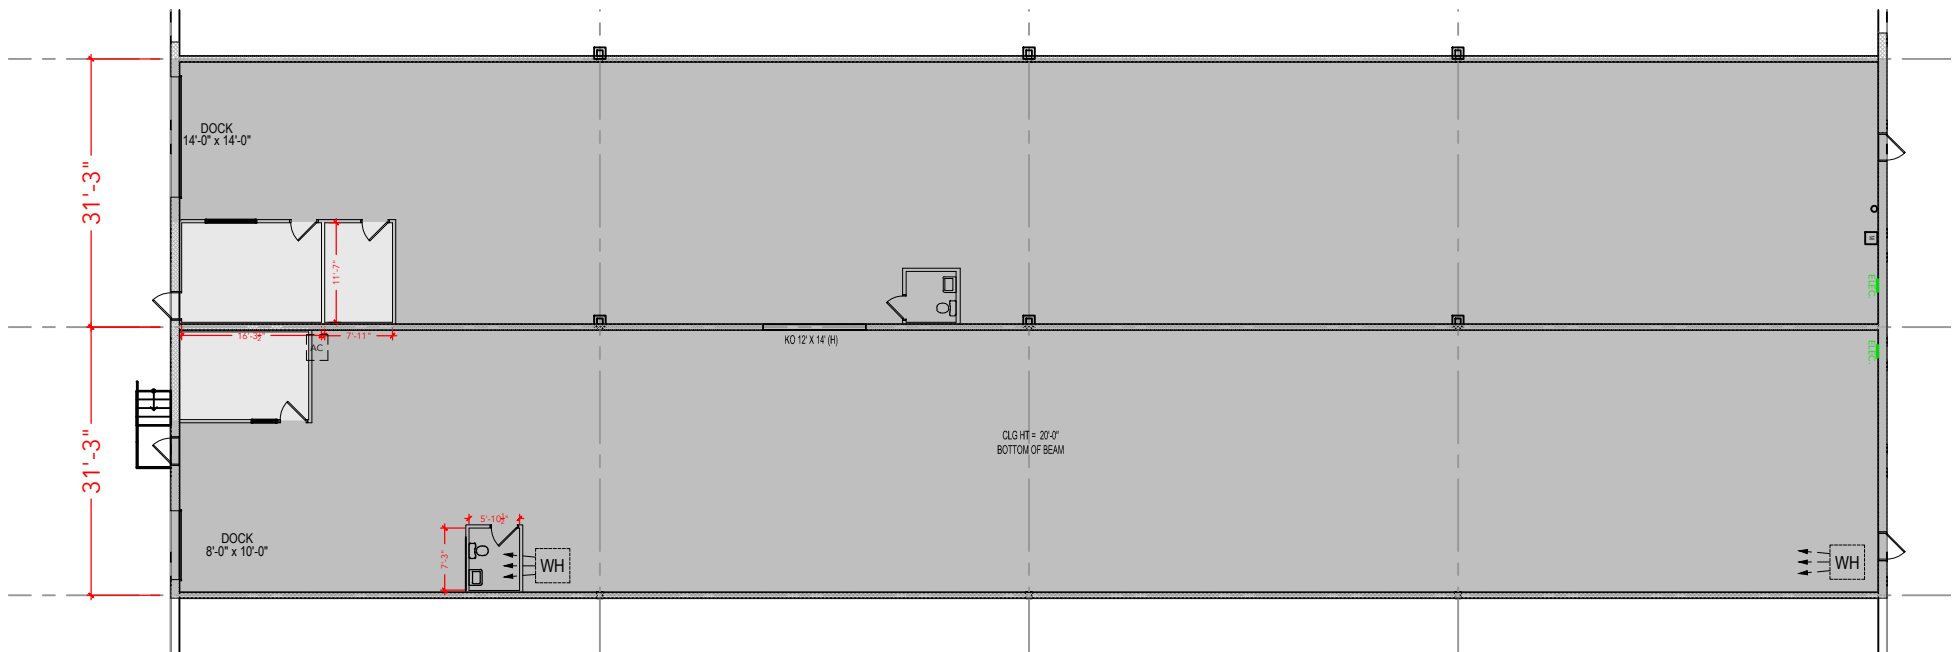

## Floor Plan