



TOTAL SF AVAILABLE - 17,835 SF

OFFICE - 7,327 SF
WAREHOUSE - 10,508 SF

[Click to access 3D model](#)

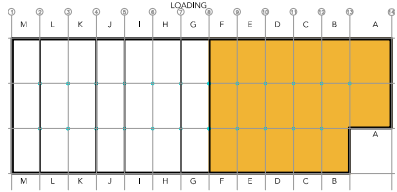

Key Plan

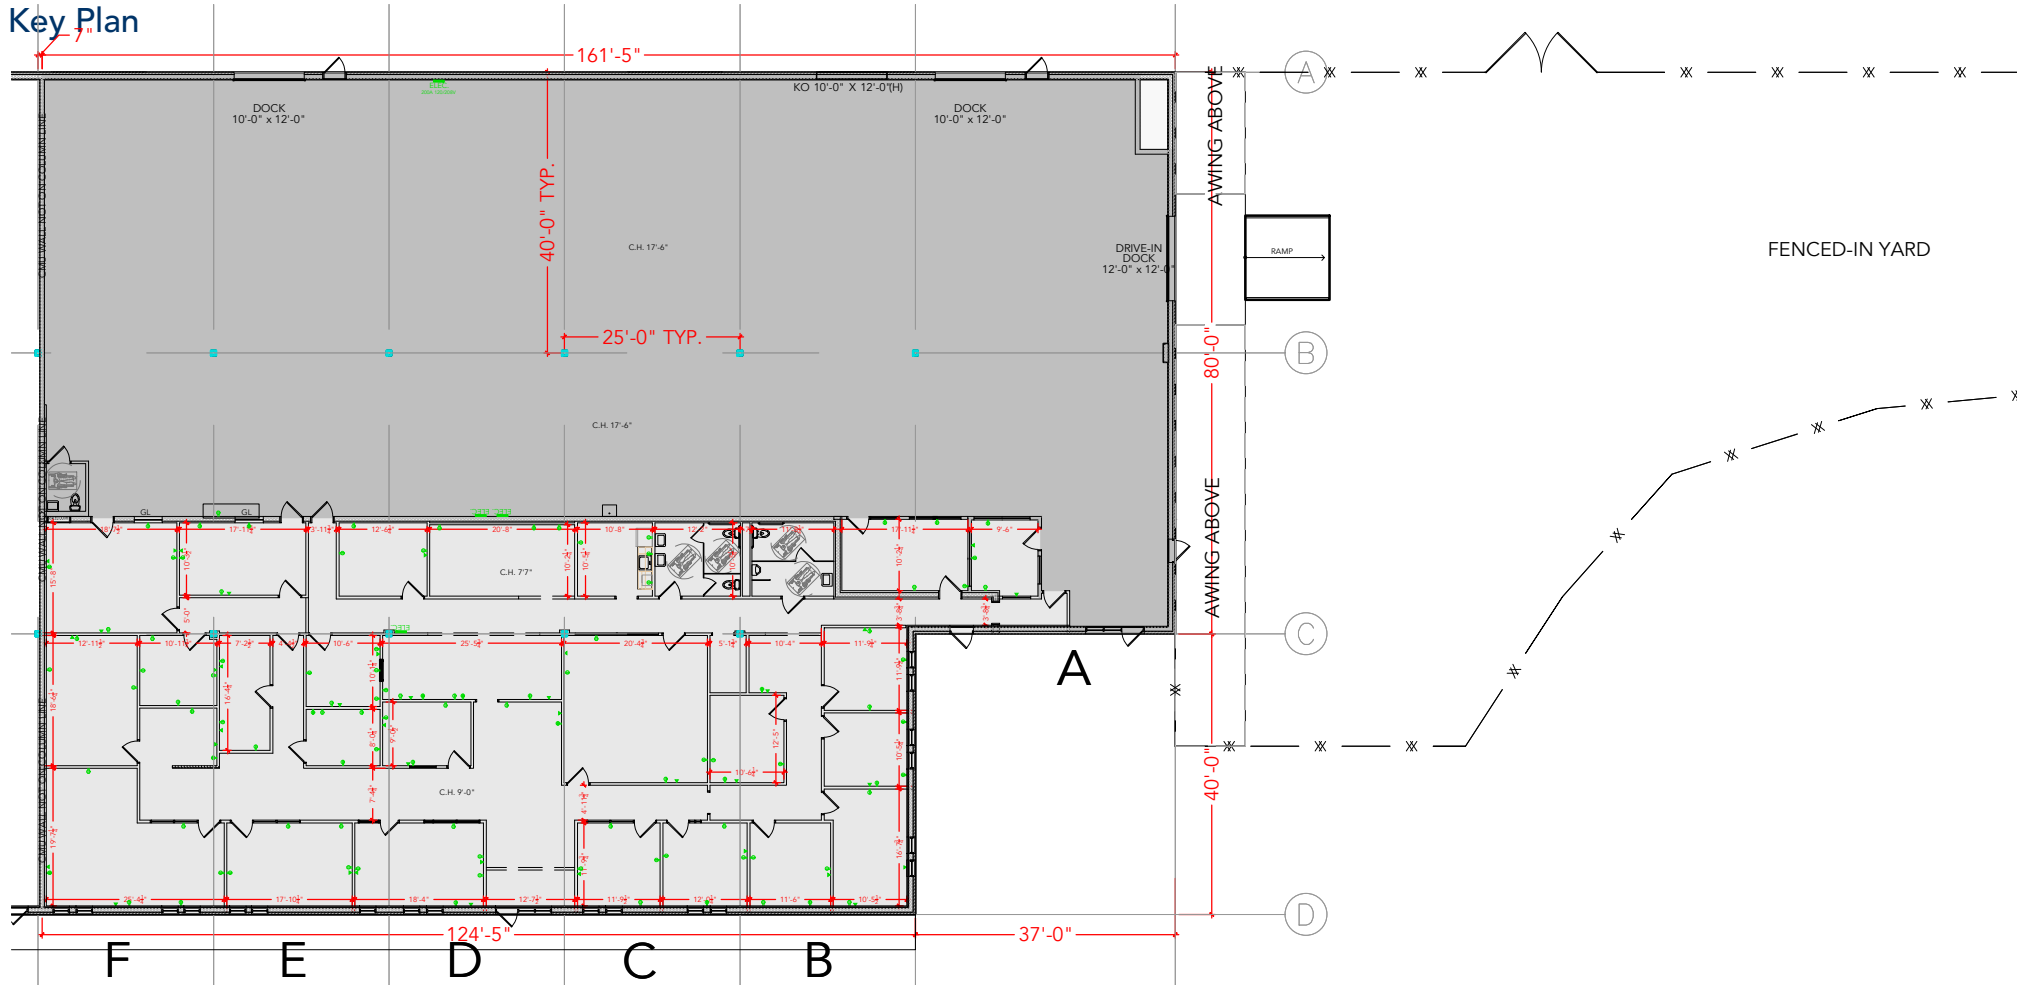

Floor Plan