



TOTAL SF AVAILABLE - 3,072 SF

OFFICE - 729 SF
WAREHOUSE SF - 2,343 SF

[Click to access 3D model](#)

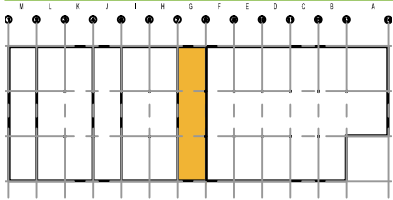

Key Plan

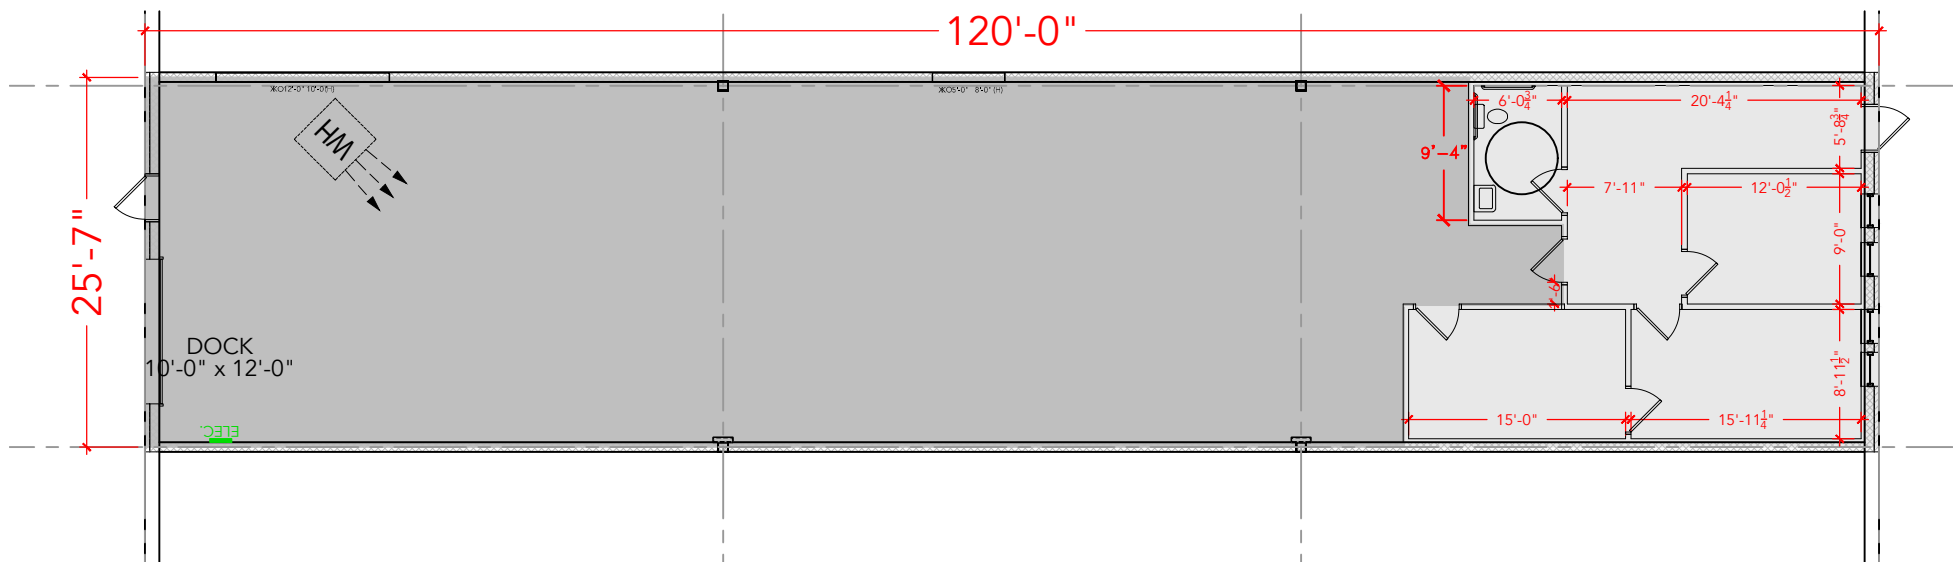

Floor Plan