


**TOTAL SF AVAILABLE - 6,000 SF**


OFFICE - 1,444 SF

WAREHOUSE SF - 4,556 SF

[Click to access 3D model](#)

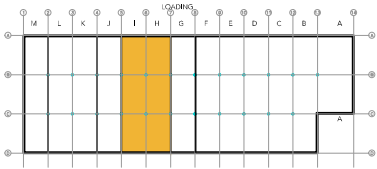

Key Plan

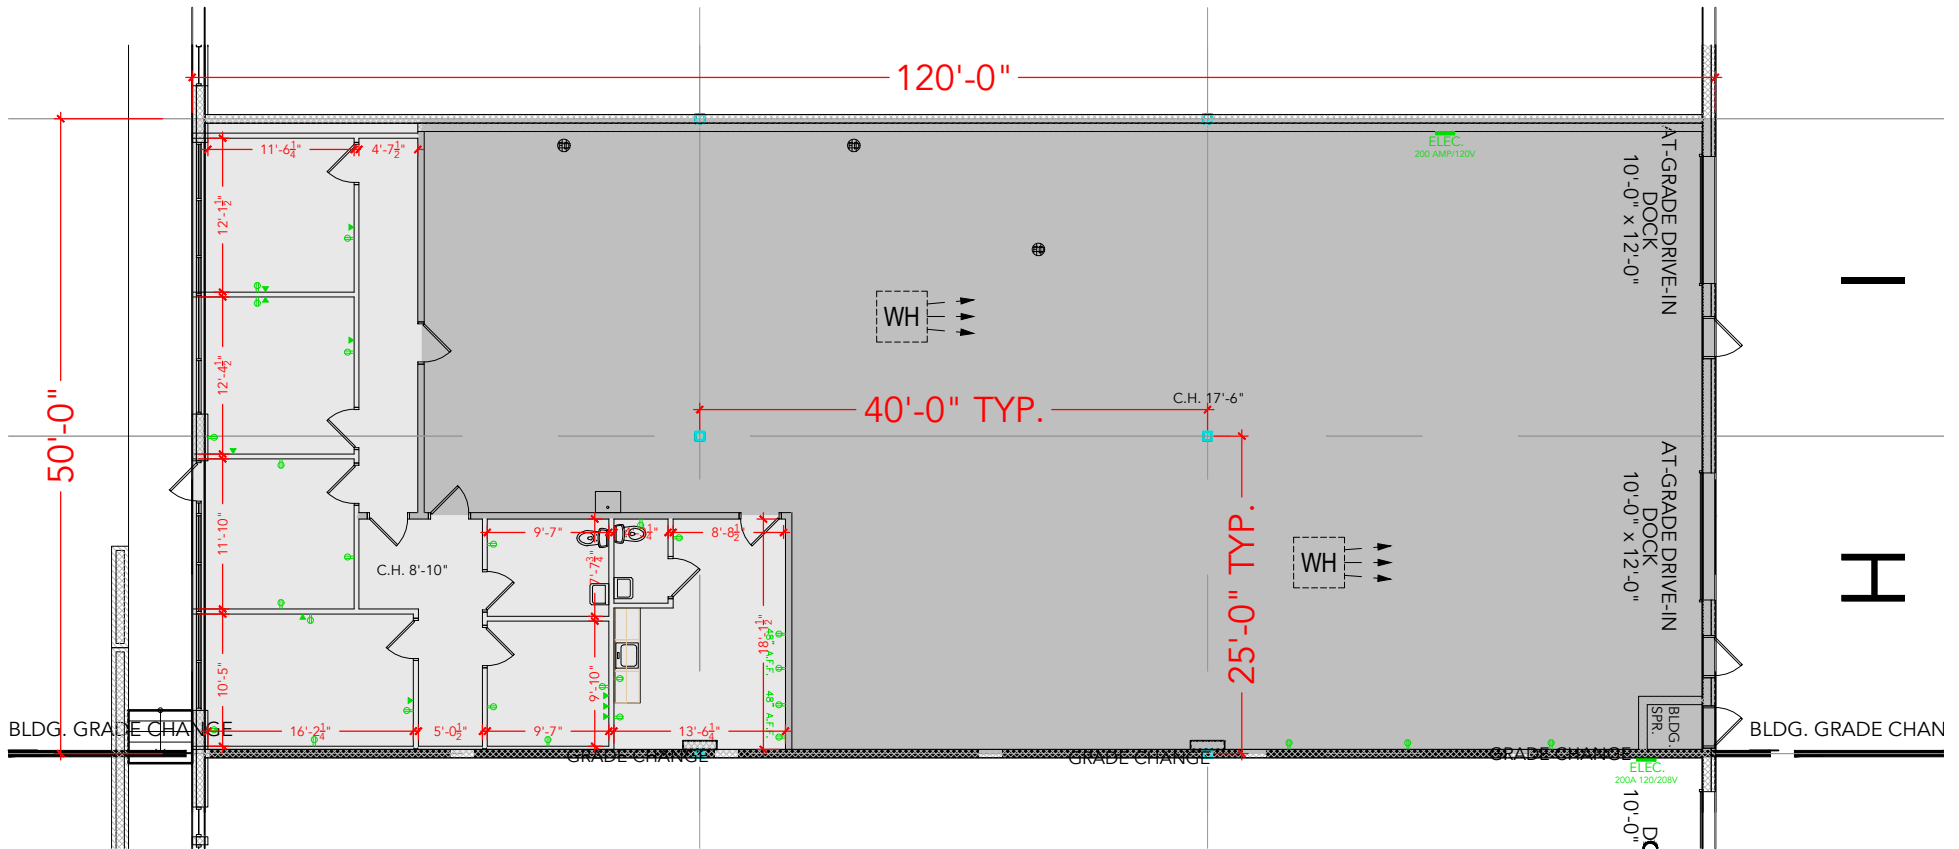

Floor Plan