


**TOTAL SF AVAILABLE -3,076 RSF**

**OFFICE - 0,000 RSF**


**WAREHOUSE - 3,076 RSF**

\* INCLUDES % OF METER ROOM

[Click to access CADD file](#)

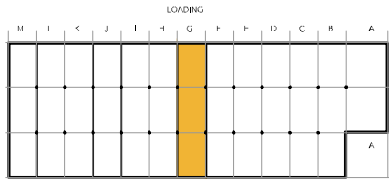

Key Plan

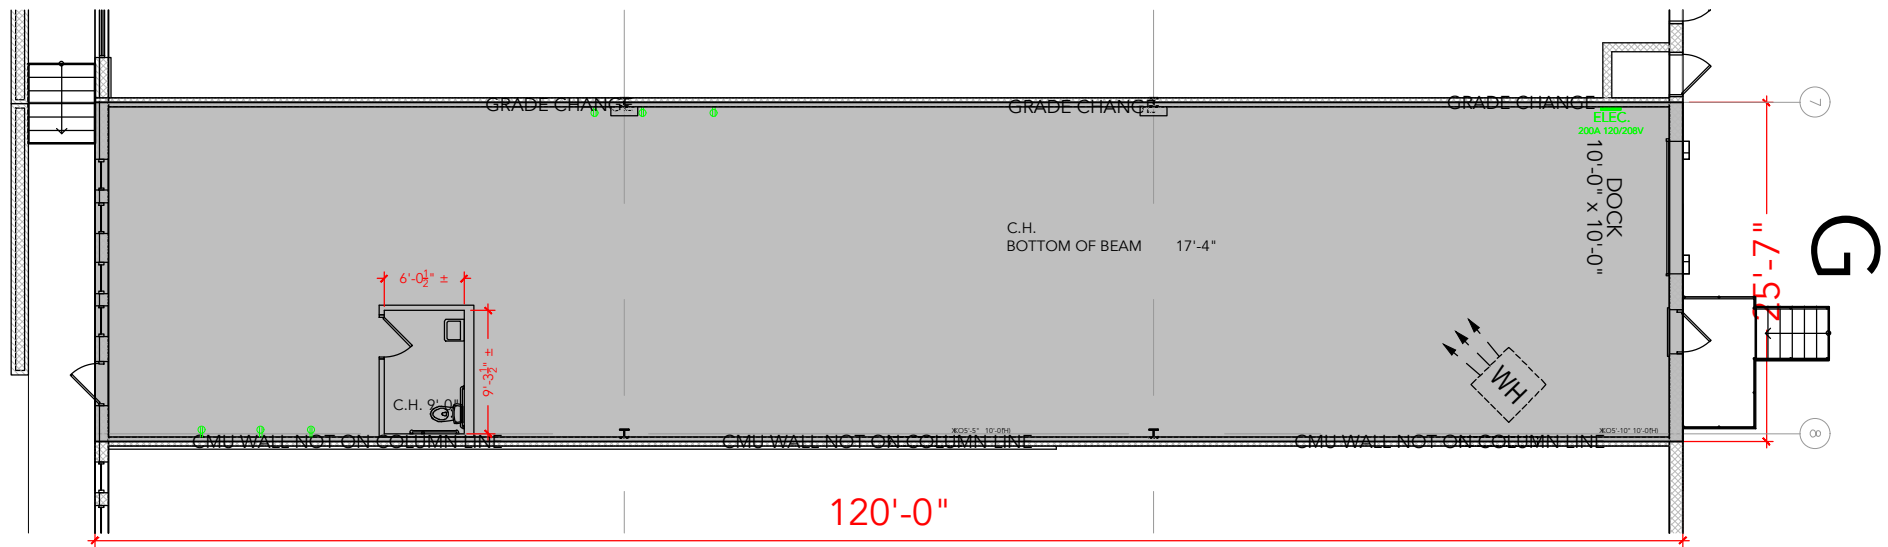

## Floor Plan