


TOTAL SF AVAILABLE - 6,000 SF


OFFICE - 4,645 SF

WAREHOUSE - 1,355 SF

[Click to access 3D model](#)

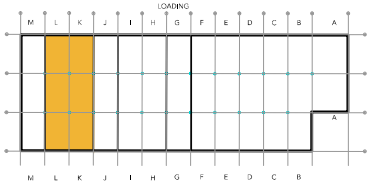

Key Plan

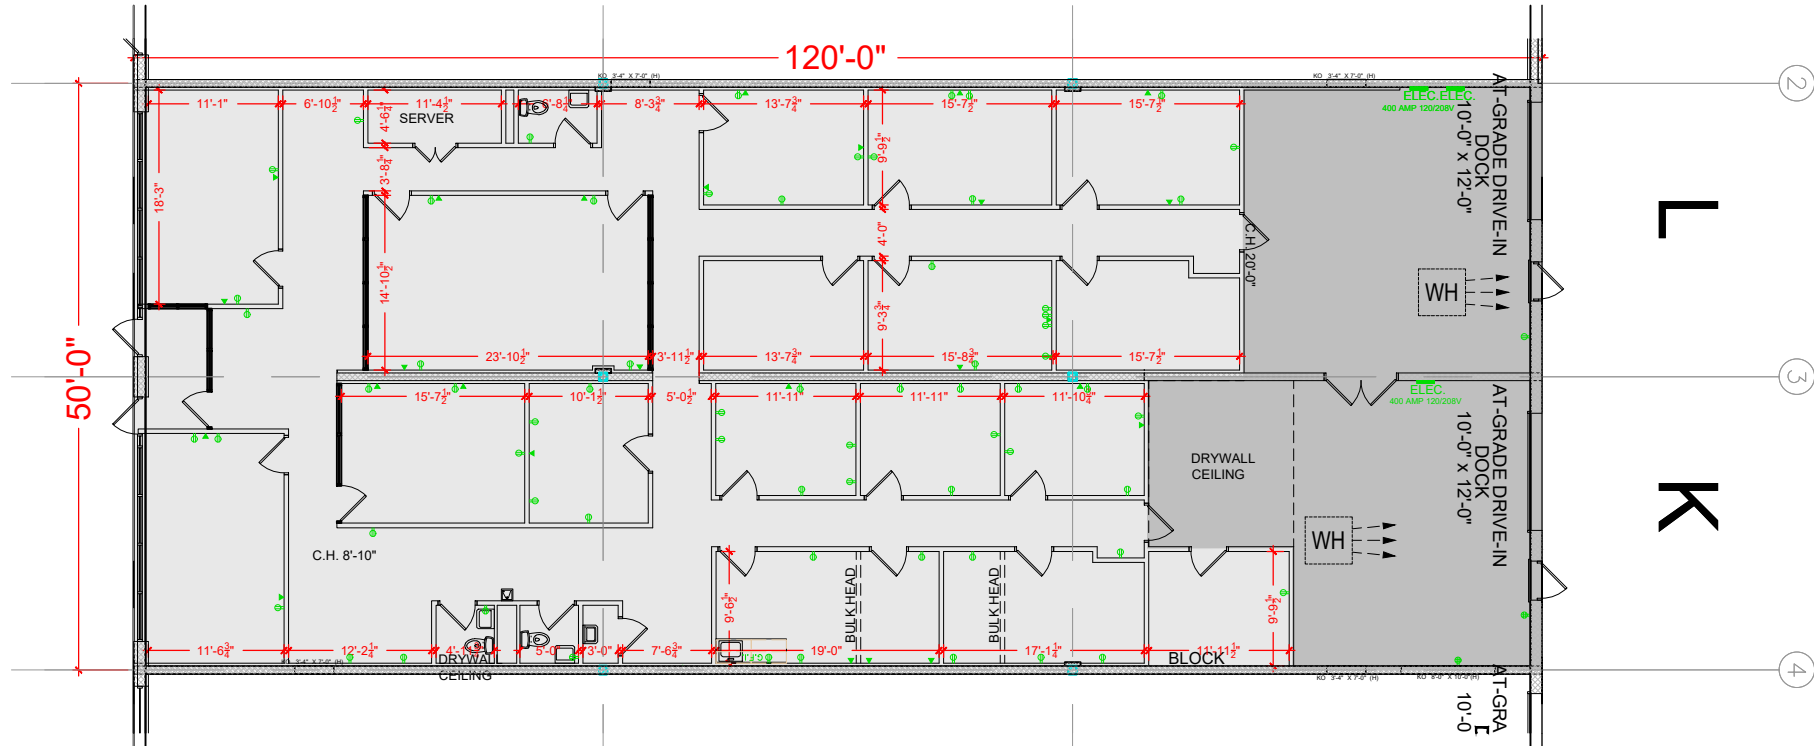

Floor Plan