



**TOTAL SF AVAILABLE - 6,000 SF**

OFFICE - 0,000 SF  
WAREHOUSE - 6,000 SF

[Click to access 3D model](#)

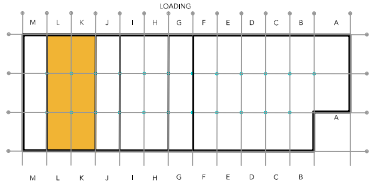

Key Plan

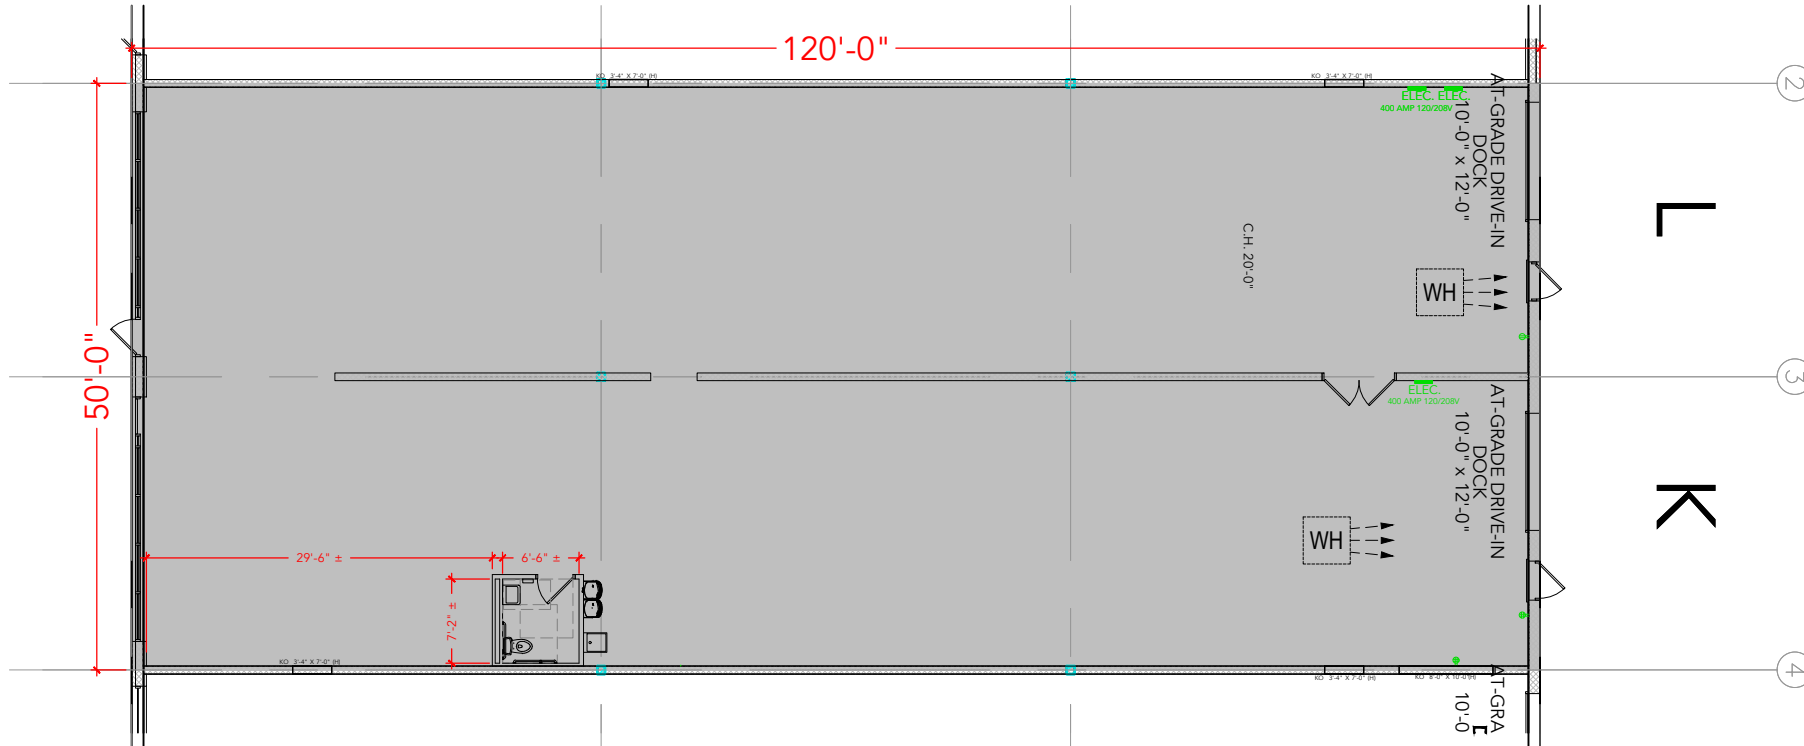

Floor Plan