


TOTAL SF AVAILABLE - 14,310 SF


OFFICE - 4,390 SF

WAREHOUSE - 9,920 SF

[Click to access 3D model](#)

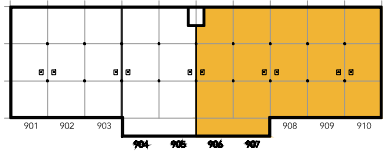

Key Plan

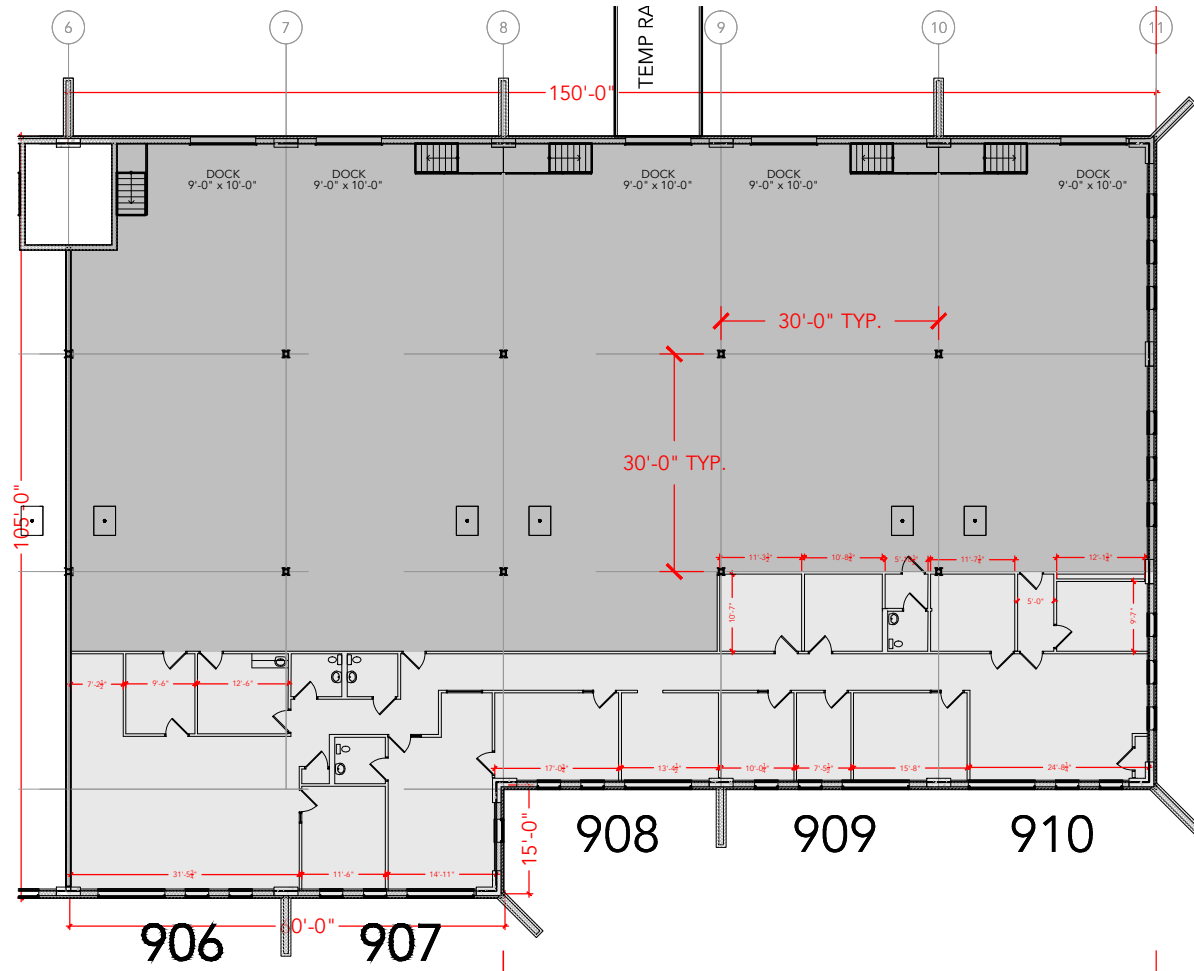

Floor Plan