

TOTAL SF AVAILABLE -12,499 RSF


OFFICE - 7,154 RSF

WAREHOUSE - 5,345 RSF


* INCLUDES % OF METER ROOM

[Click to access CADD file](#)

* 927 SQFT MEZZ. NOT INCLUDED IN TOTAL SQFT

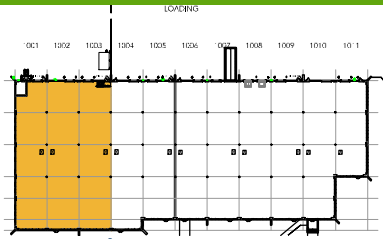

Key Plan

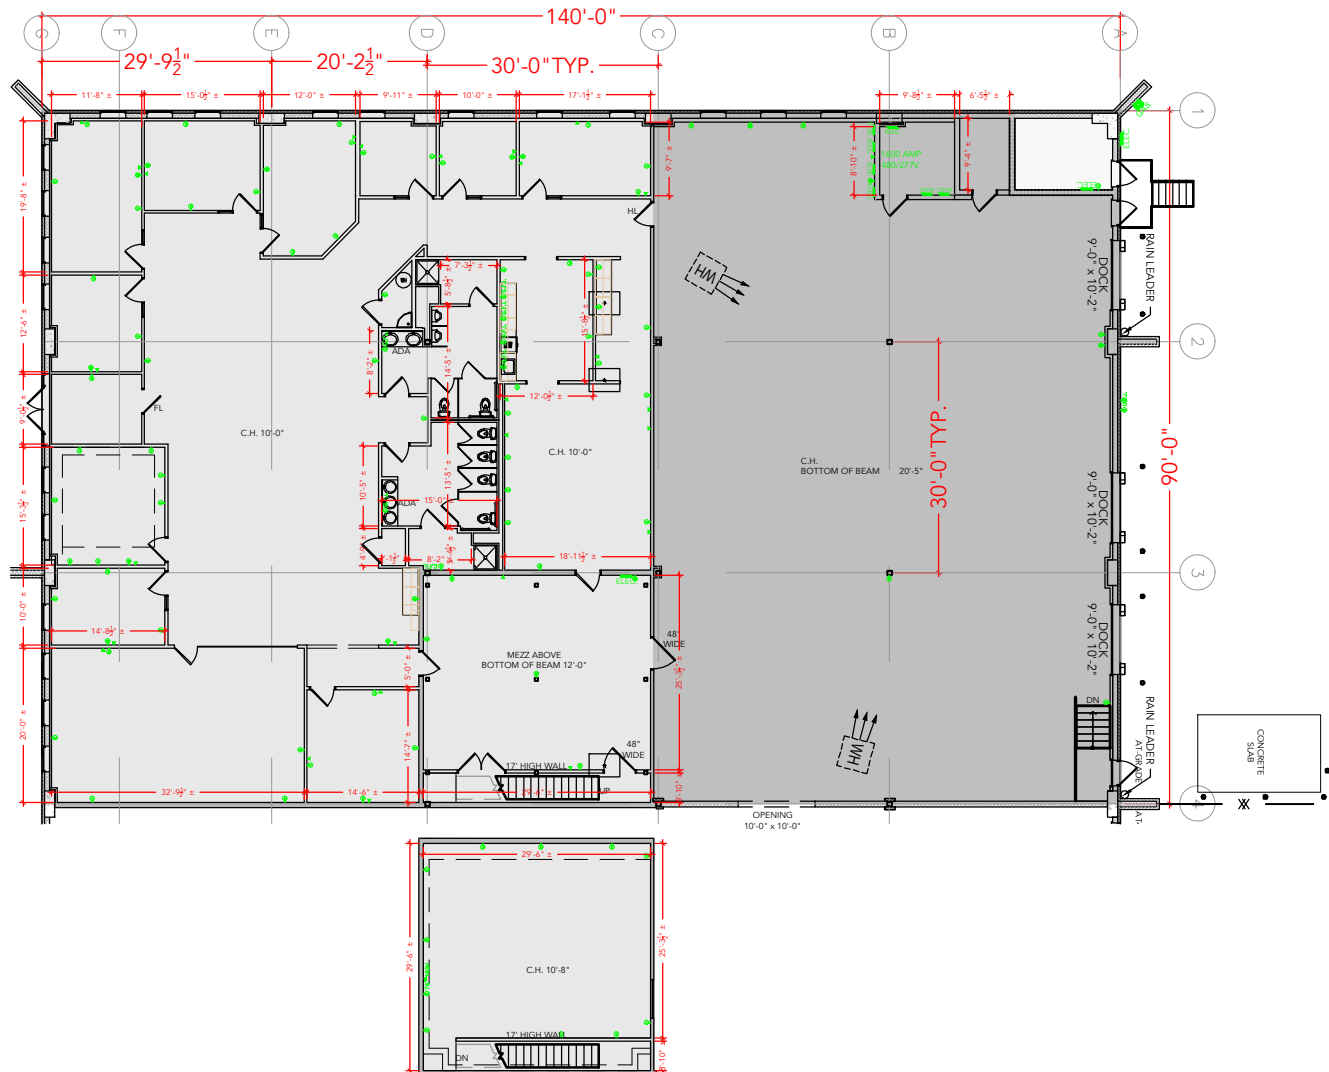

Floor Plan

PLAN NOT TO SCALE - THIS IS NOT A CONSTRUCTION DOCUMENT

DRAWING #: 091-3710-1001-1003 ASBUILT DATE: 05.14.2026