


TOTAL SF AVAILABLE - 22,200 SF


OFFICE - 10,220 SF

WAREHOUSE SF - 11,980 SF

[Click to access 3D model](#)

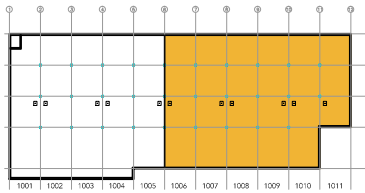

Key Plan

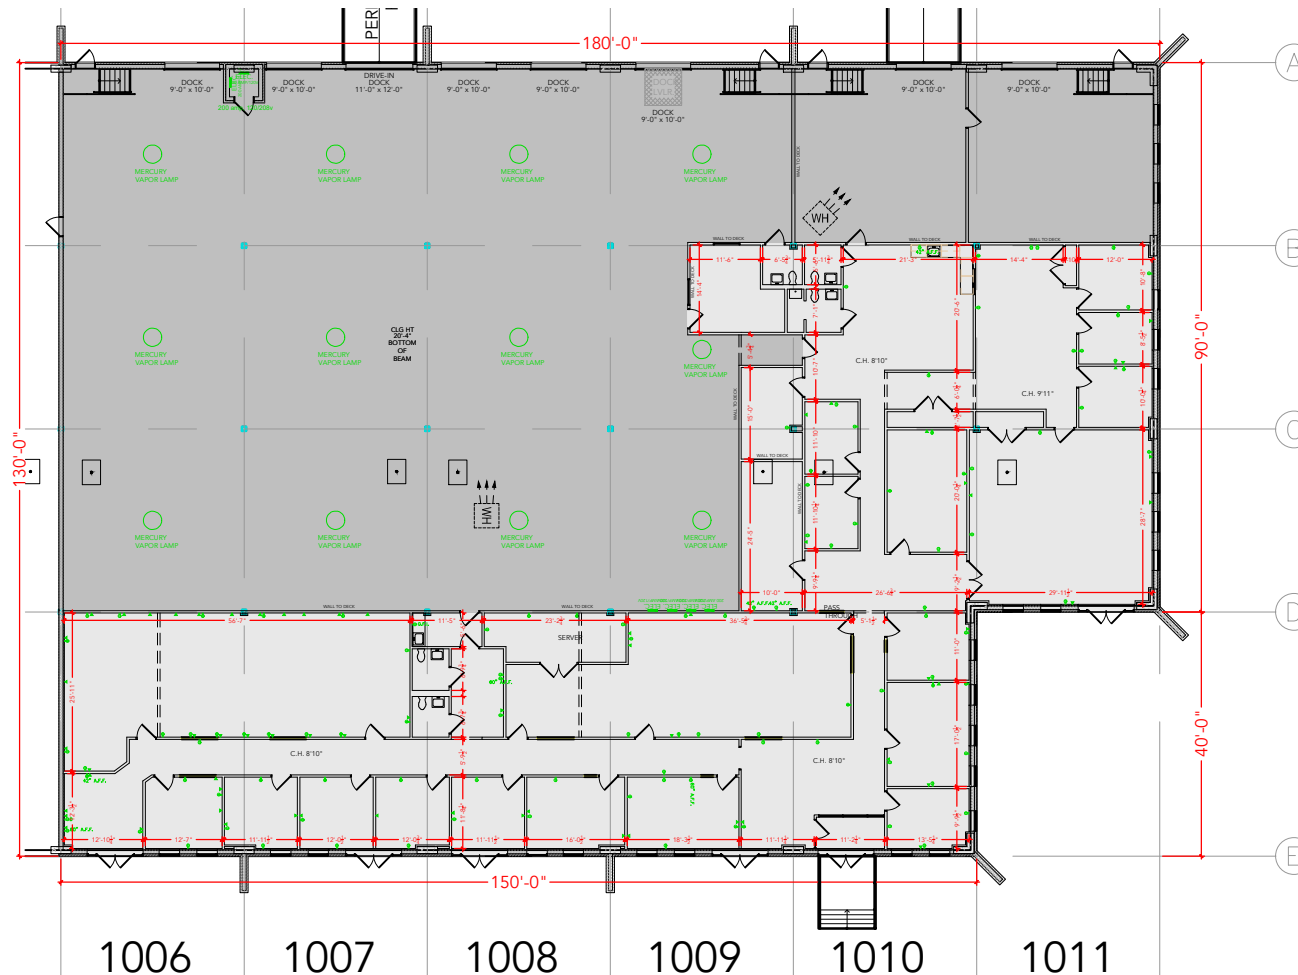

Floor Plan