


TOTAL SF AVAILABLE - 3,000 SF

OFFICE - 0,000 SF


WAREHOUSE - 3,000 SF

[Click to access CADD file](#)

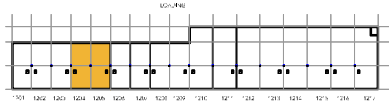

Key Plan

1204
1205

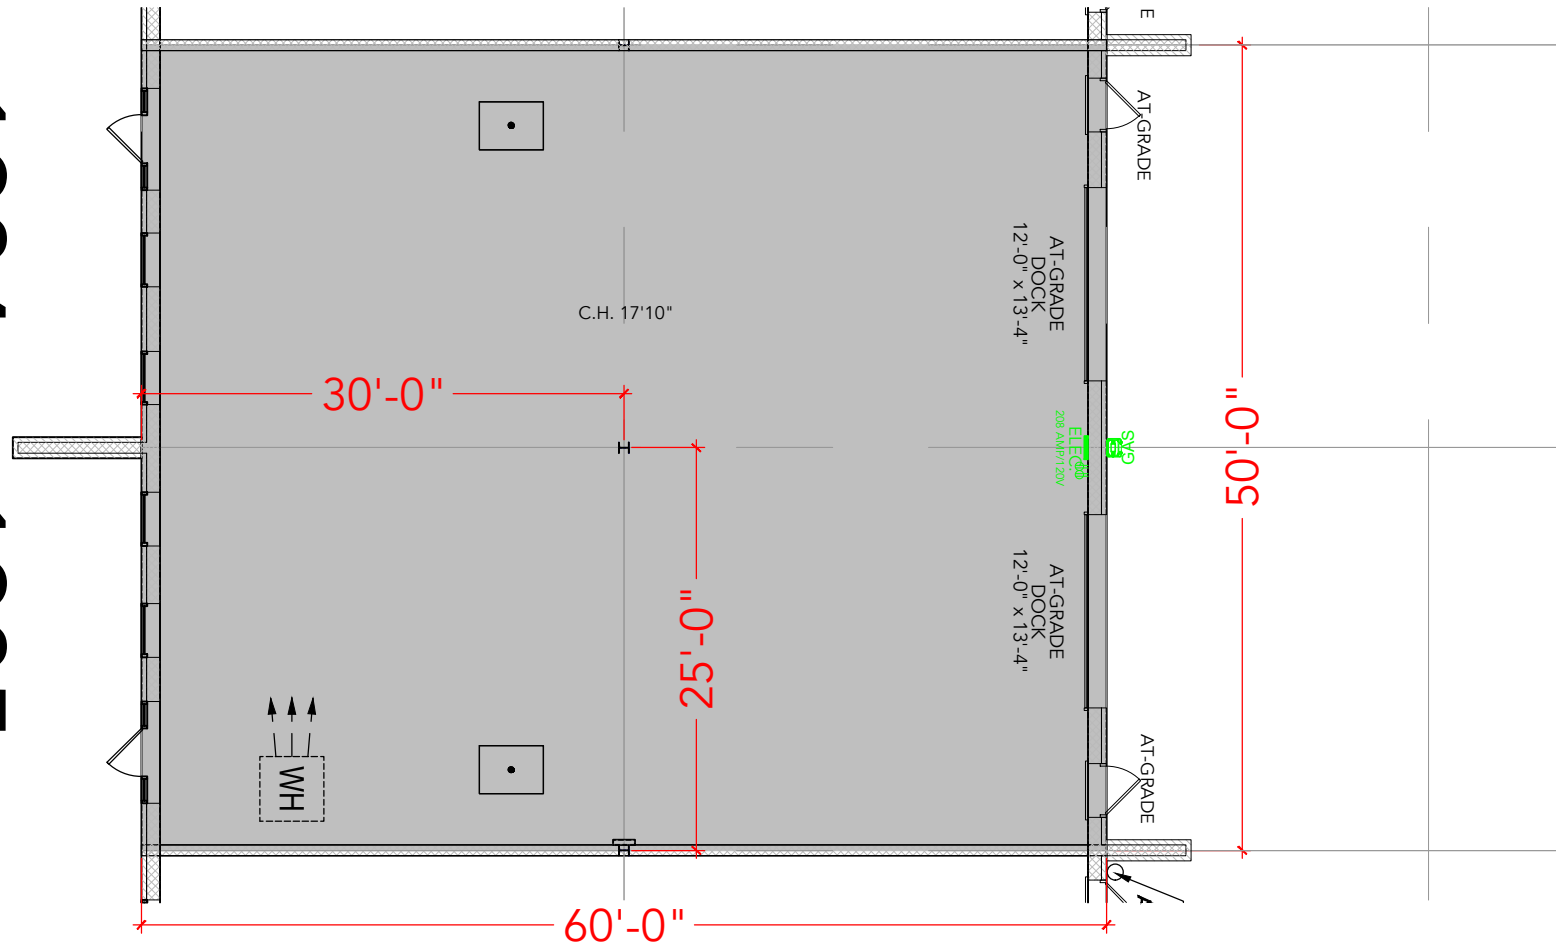

Floor Plan