


TOTAL SF AVAILABLE -1,500 SF


OFFICE - 386 SF

WAREHOUSE SF - 1,114 SF

[Click to access3D model](#)

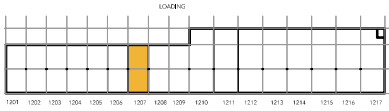

Key Plan

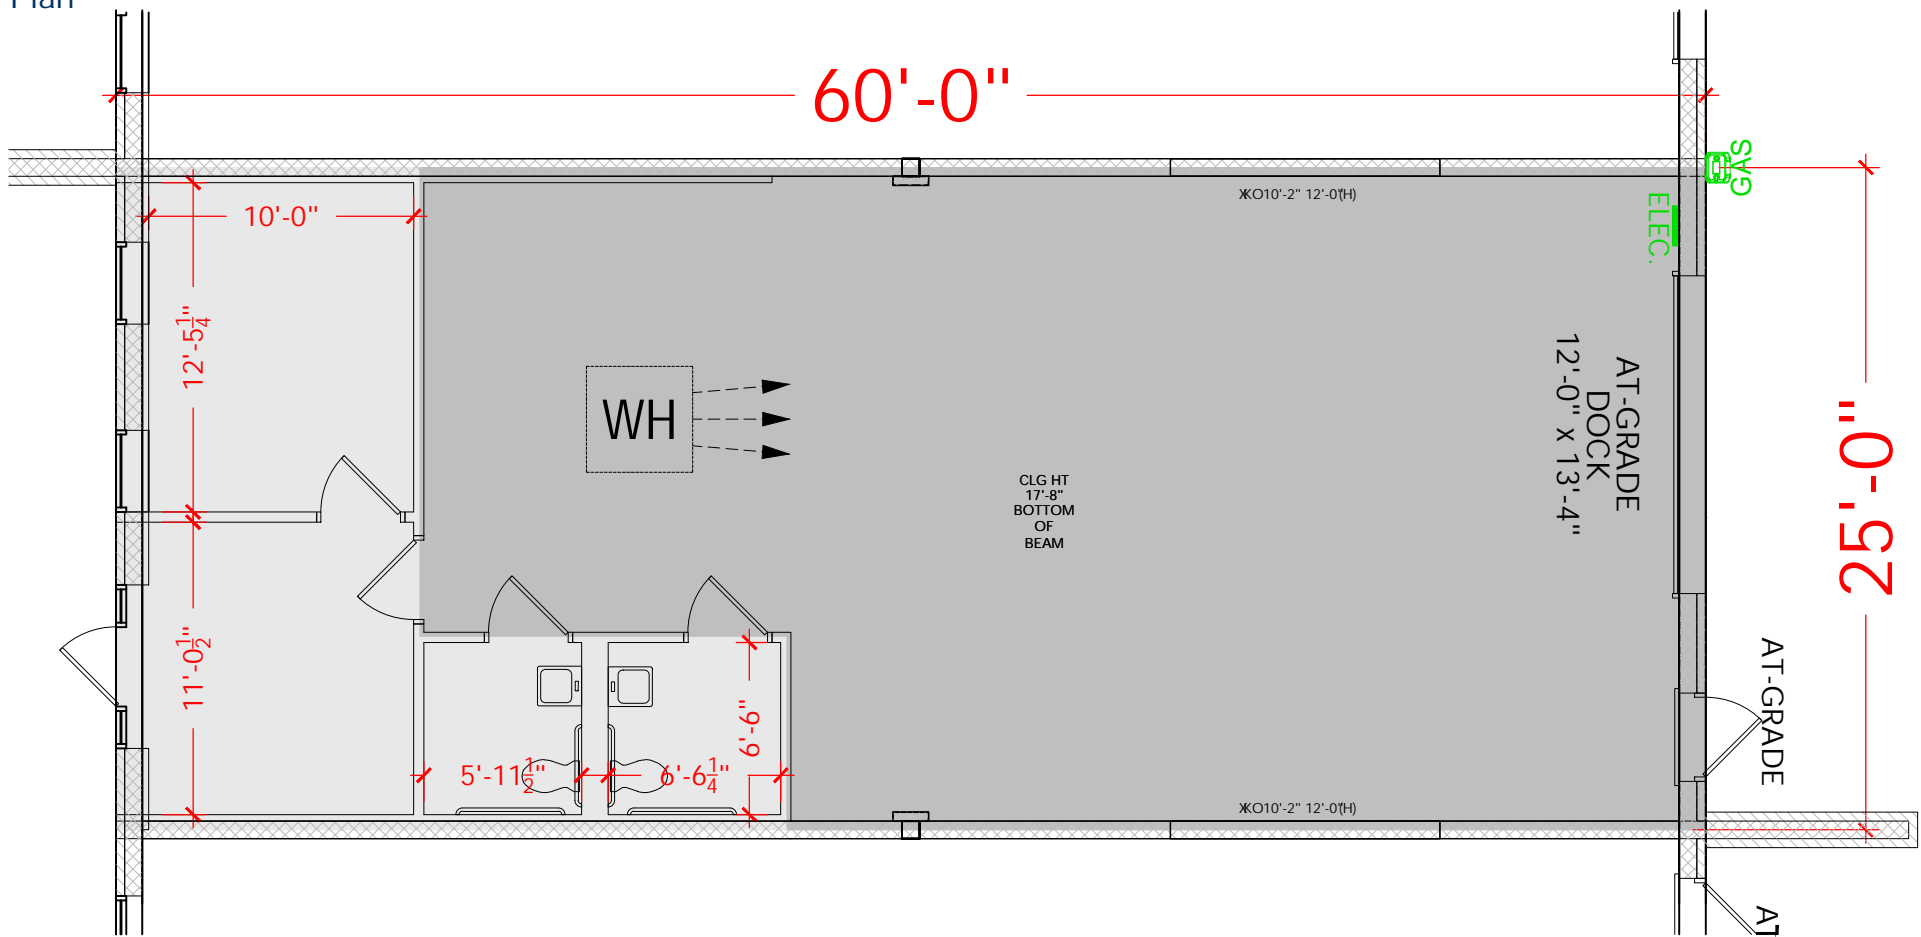

Floor Plan