


TOTAL SF AVAILABLE - 5,400 SF


OFFICE - 1,686 SF

WAREHOUSE SF - 3,714 SF

[Click to access 3D model](#)

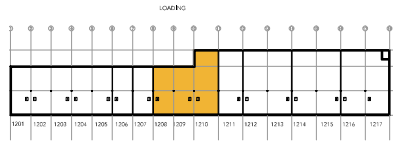

Key Plan

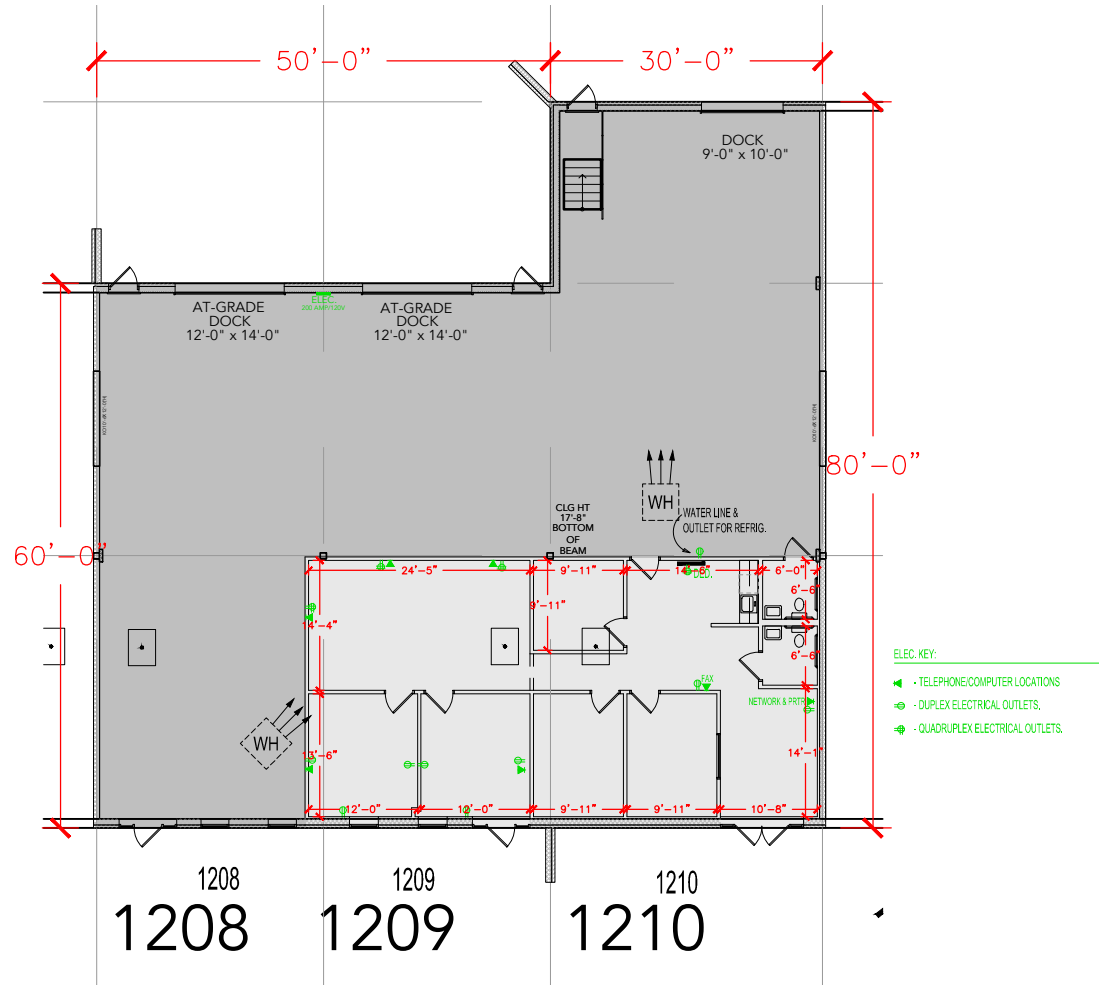

Floor Plan