


TOTAL SF AVAILABLE - 2,400 SF


OFFICE - 1,113 SF

WAREHOUSE - 1,287 SF

[Click to access 3D model](#)

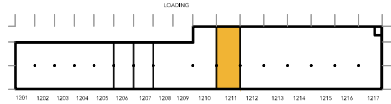

Key Plan

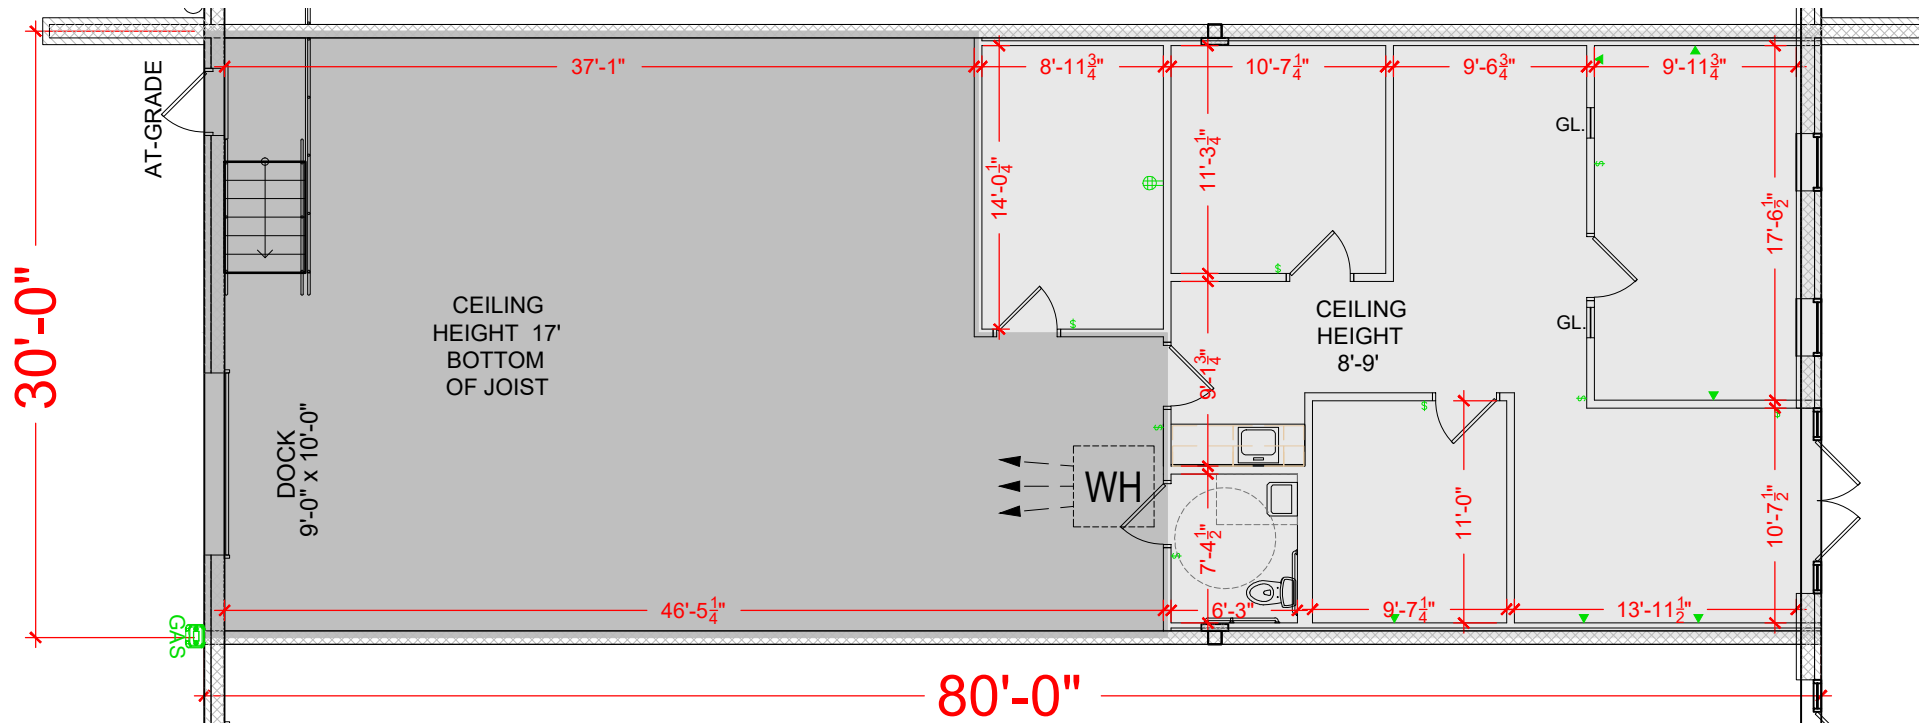

Floor Plan