

**TOTAL SF AVAILABLE - 4,800 SF**


**OFFICE - 2,462 SF**

**WAREHOUSE - 2,338 SF**

[Click to access CADD file](#)



Key Plan

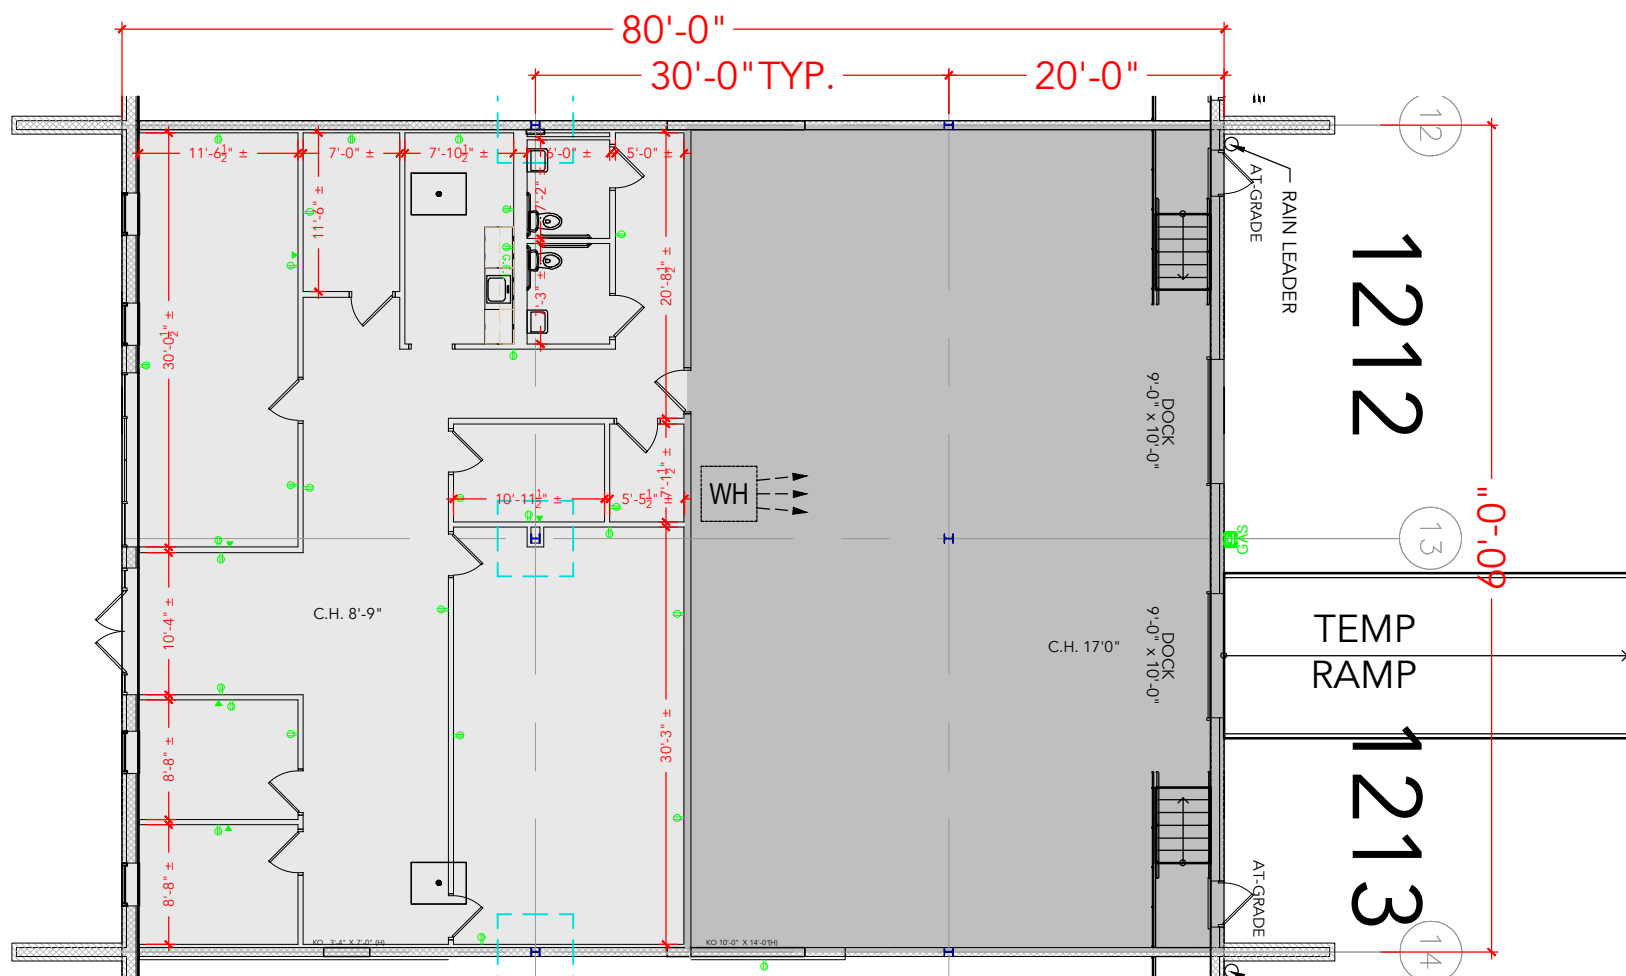

Floor Plan