

TOTAL SF AVAILABLE - 4,800 SF


OFFICE - 2,962 SF

WAREHOUSE - 1,838 SF

[Click to access 3D model](#)



Key Plan

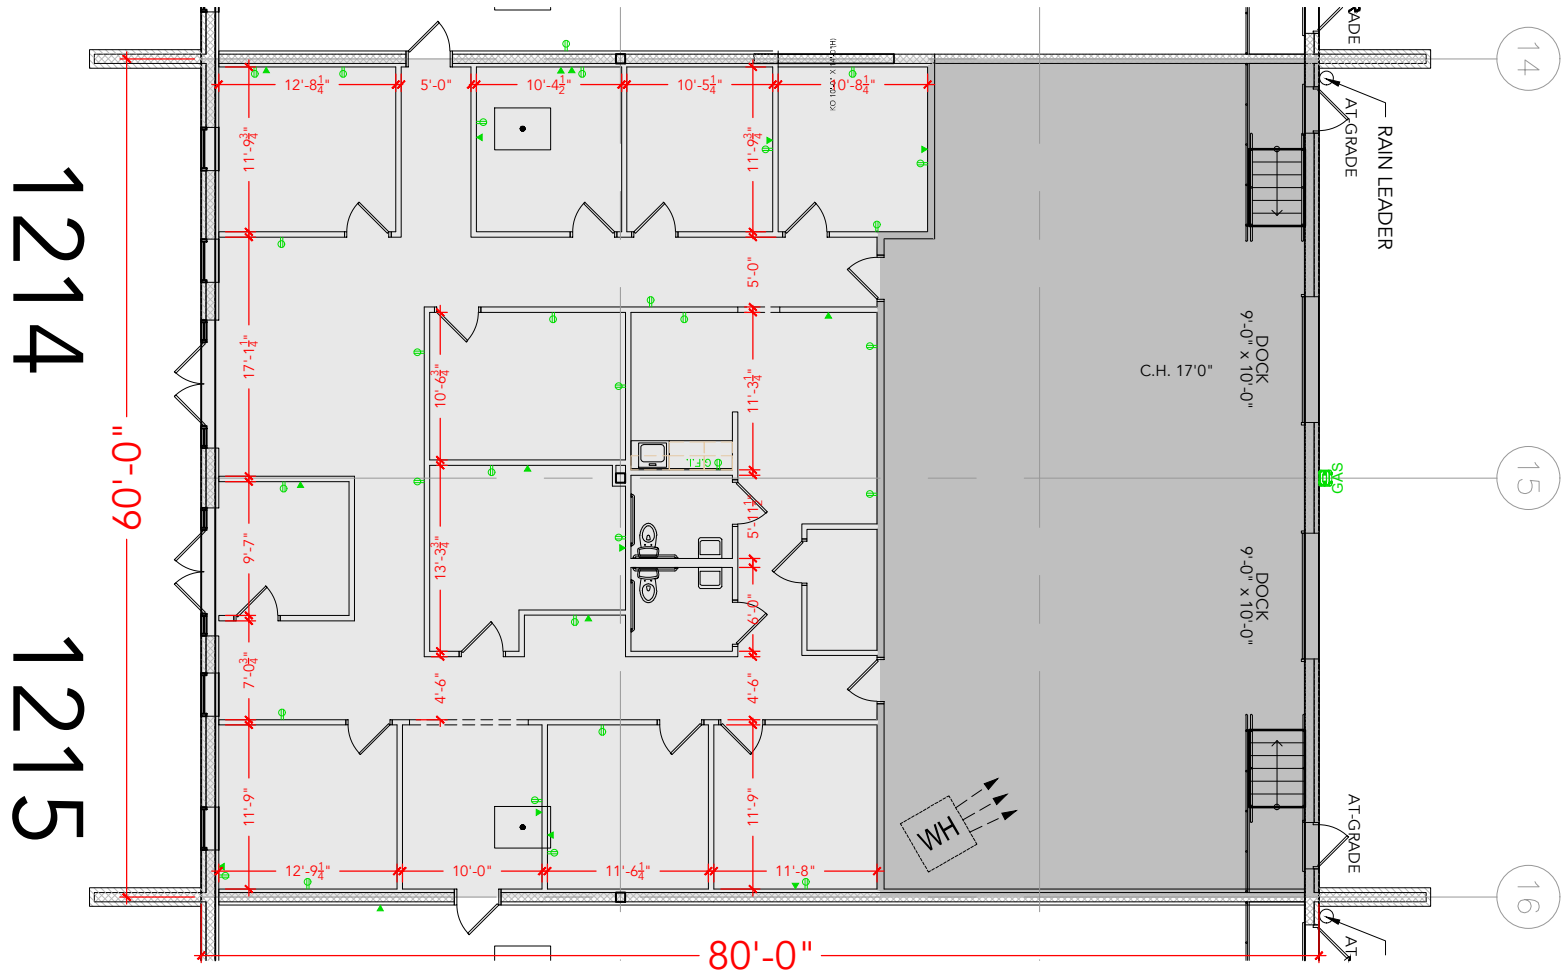

Floor Plan