


TOTAL SF AVAILABLE - 13,950 SF


OFFICE - 7,680 SF

WAREHOUSE - 6,270 SF

[Click to access 3D model](#)

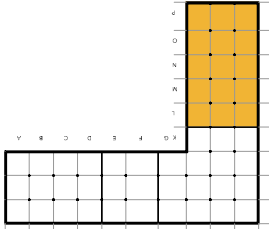

Key Plan

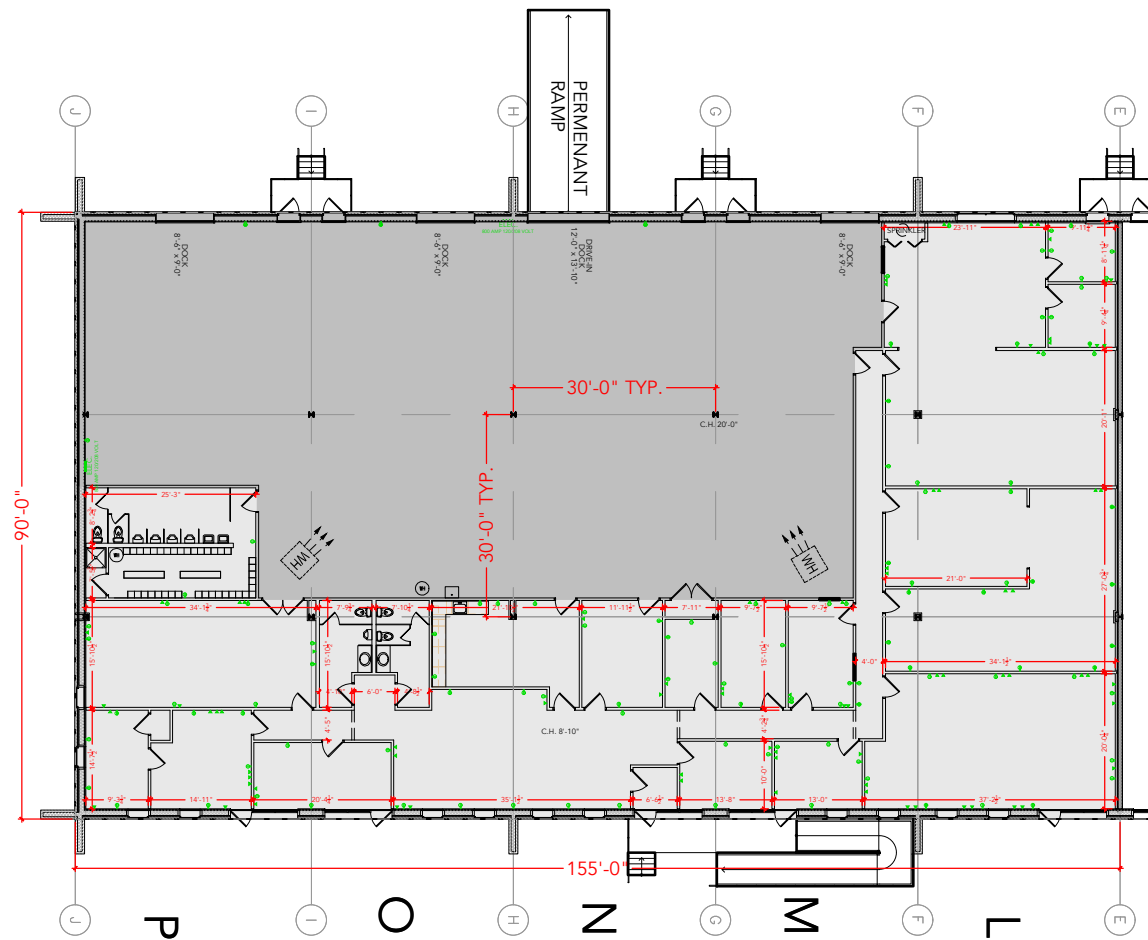

Floor Plan