

CURTIS PARCEL A


709 EAST ORDNANCE RD BALTIMORE, MD 21226
SUITE 504

TOTAL SF AVAILABLE - 2,700 SF


OFFICE - 1,677 SF

WAREHOUSE SF - 1,023 SF

[Click to access 3D model](#)

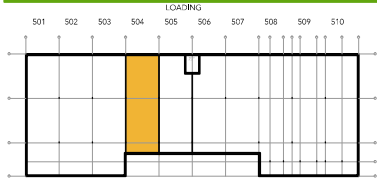

Key Plan

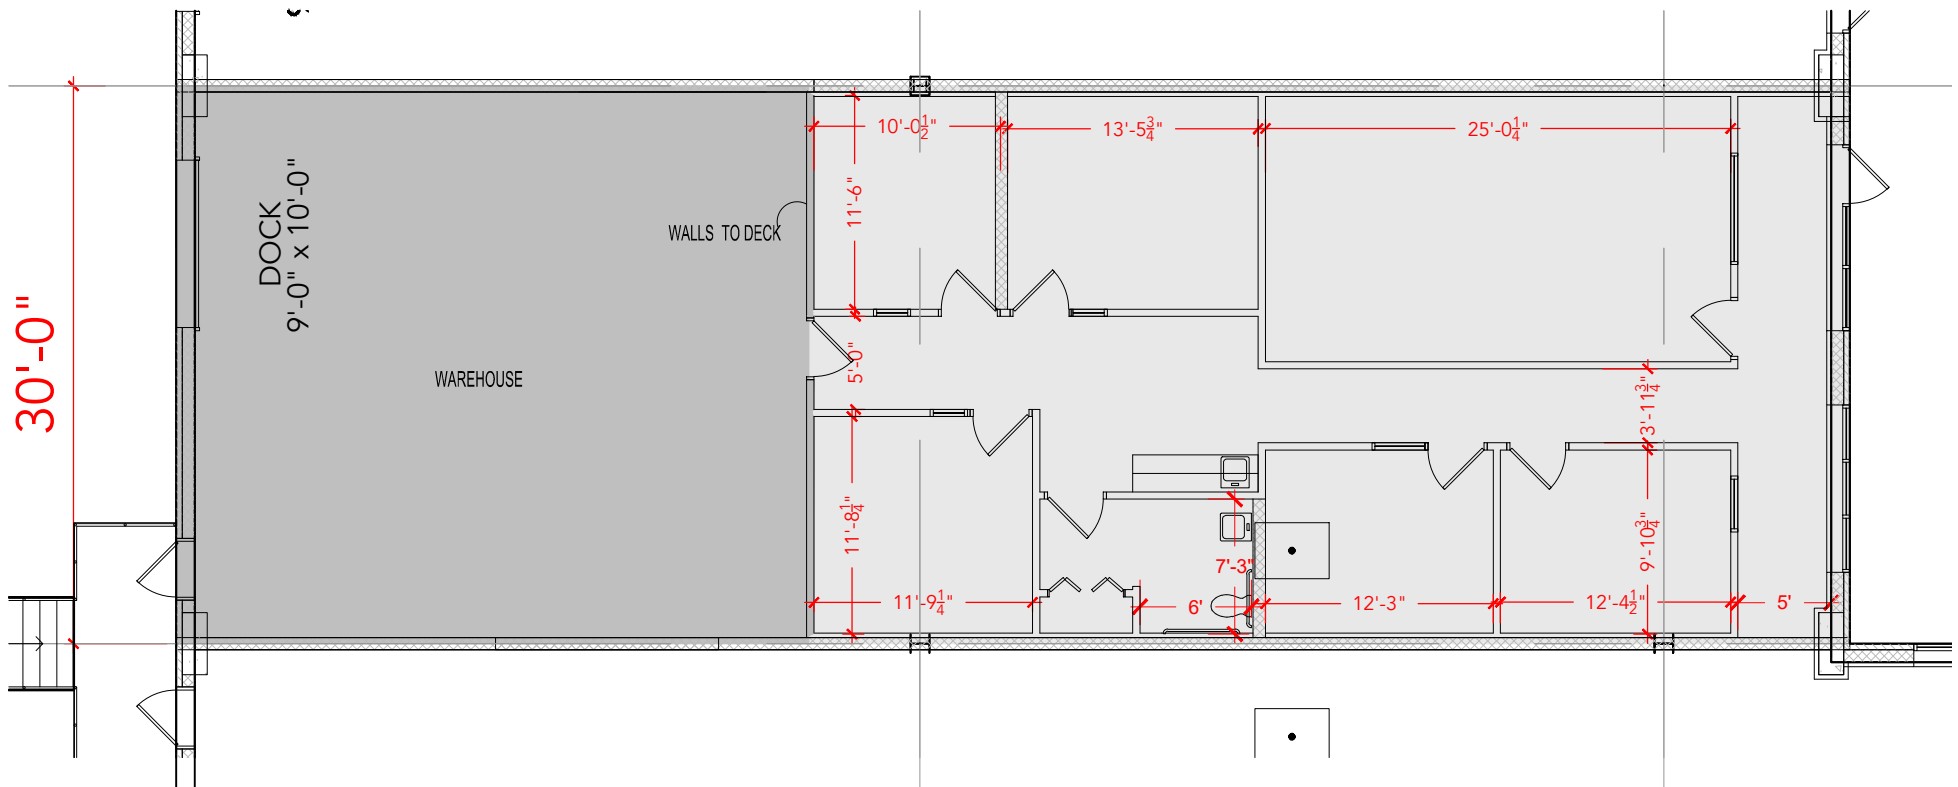

Floor Plan