


TOTAL SF AVAILABLE -4,200 SF


OFFICE - 4,200 SF

WAREHOUSE - 0,000 SF

[Click to access CADD file](#)

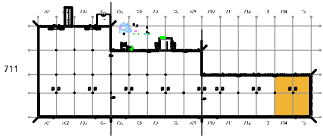

Key Plan

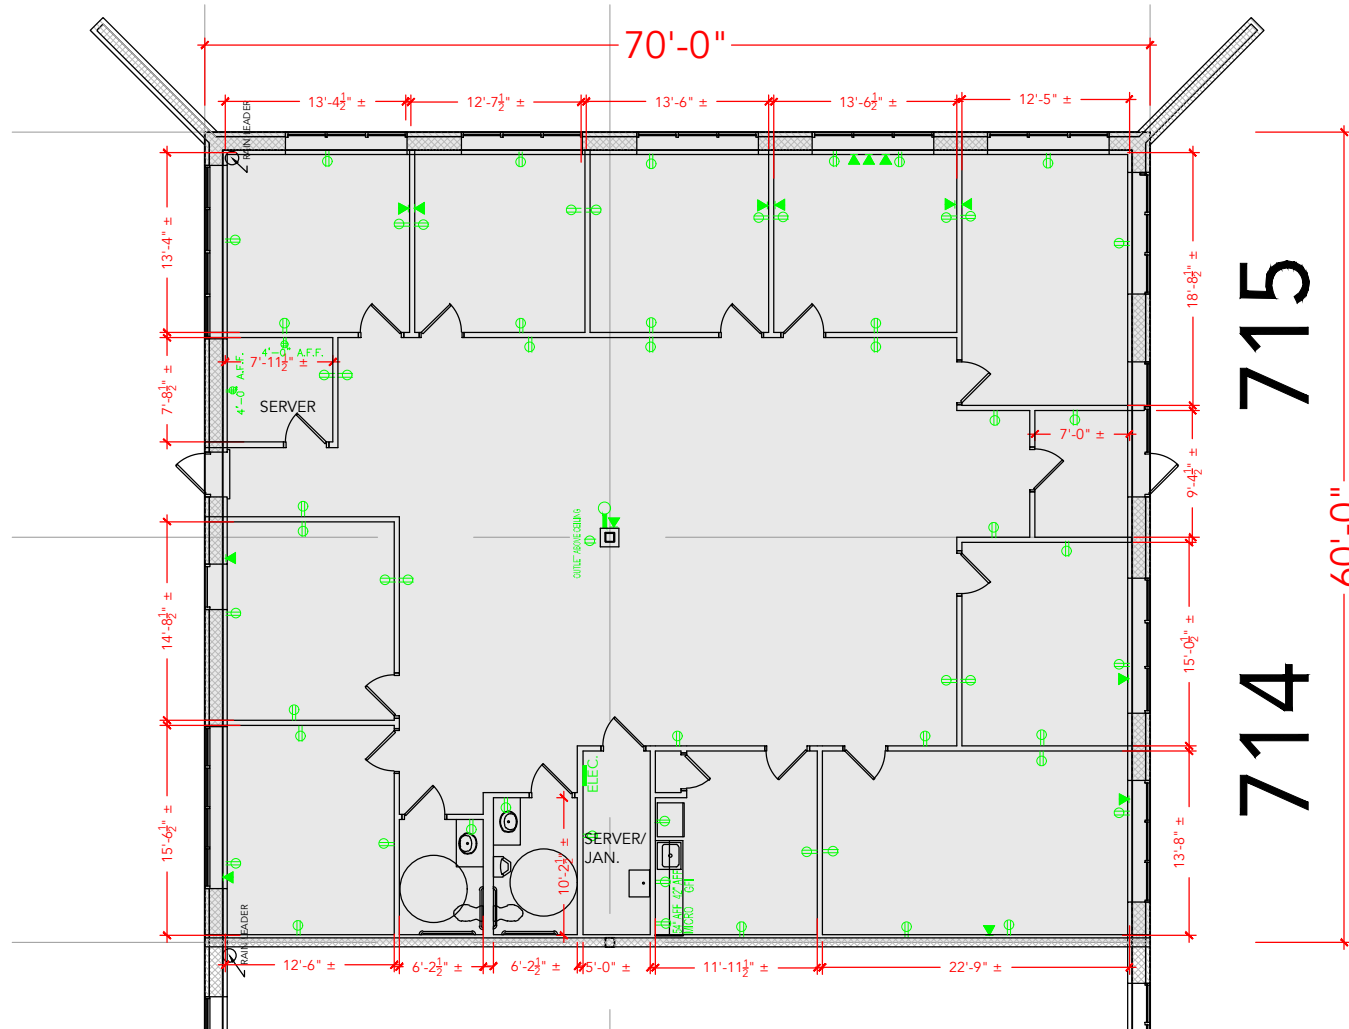

Floor Plan