



# Curtis Business Center

705 East Ordance Road  
Suites 100-106  
Baltimore, MD 21226

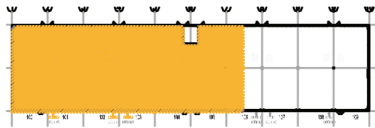

Building Key Plan

Total SF Available  
9,589 SF

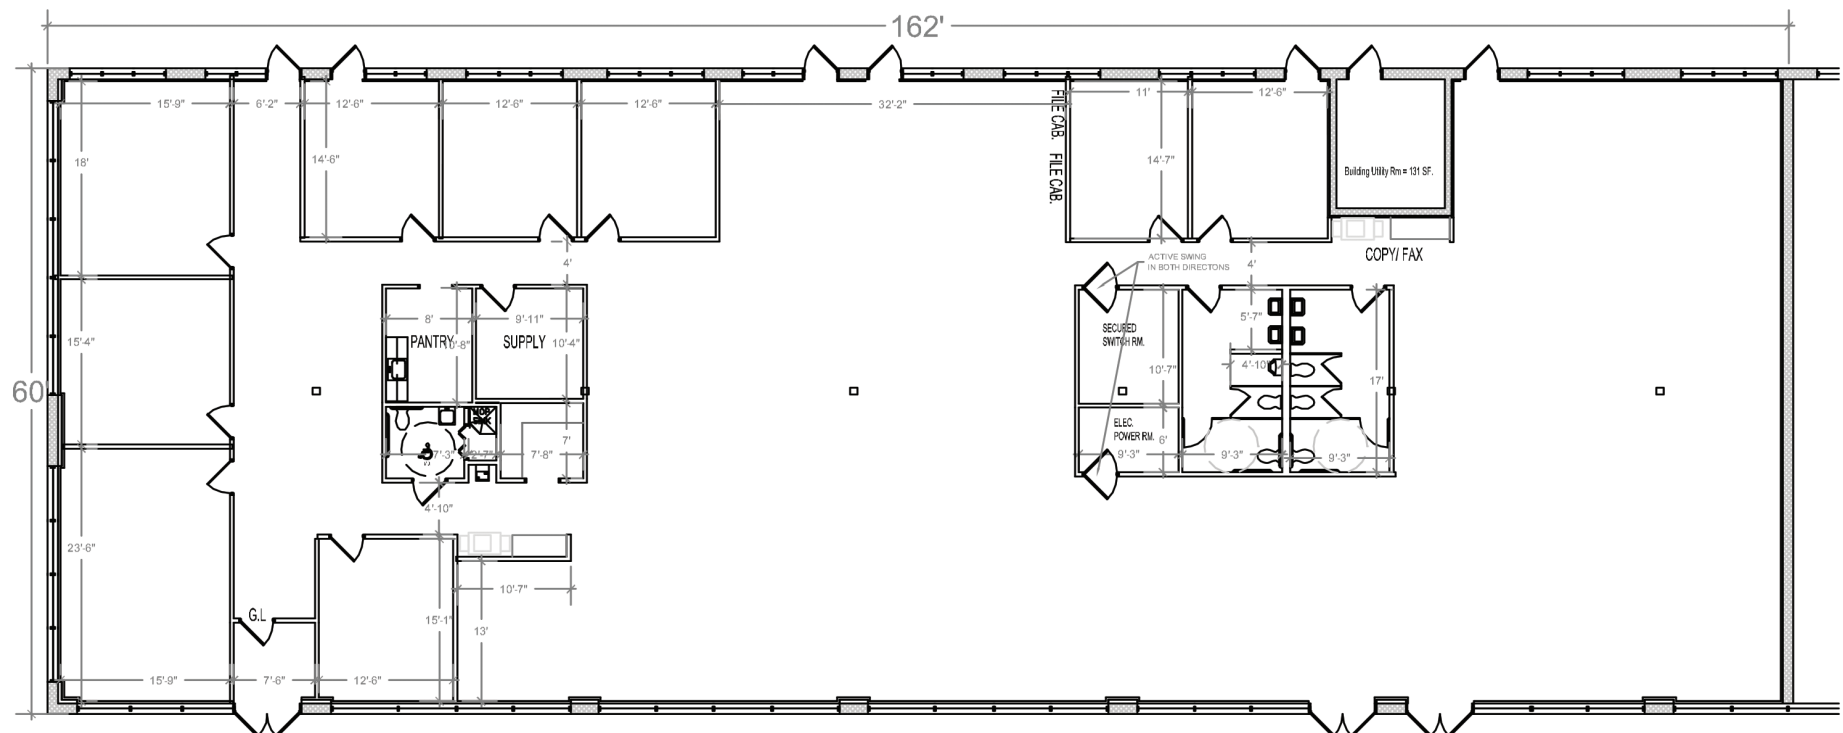

Plan not to scale - this is not a construction document.