

Key Plan

TOTAL SF AVAILABLE - 3,319 RSF


OFFICE - 1,159 RSF

WAREHOUSE - 2,160 RSF

[Click to access CADD file](#)

Floor Plan

PLAN NOT TO SCALE - THIS IS NOT A CONSTRUCTION DOCUMENT

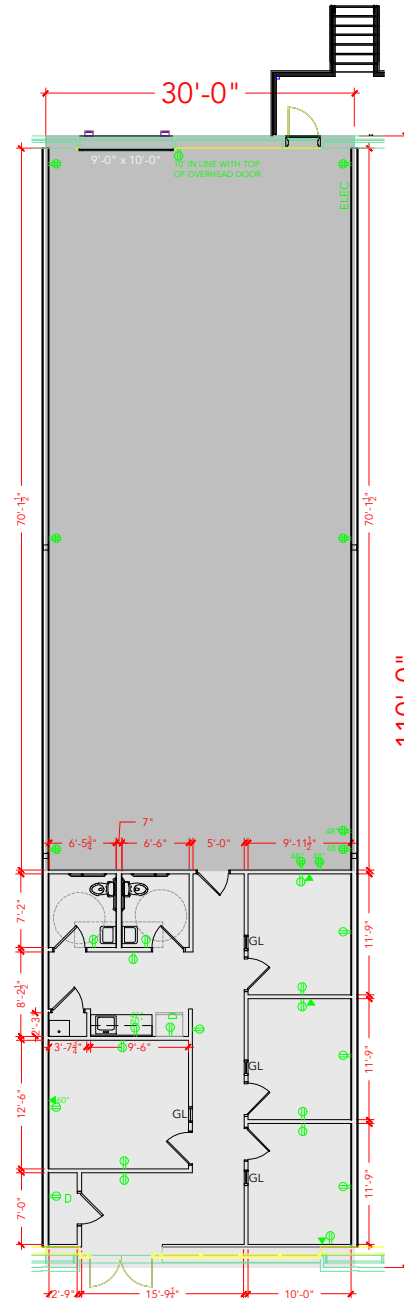

DRAWING #: WF1-C1-119 ASBUILT DATE: **NEEDS TO BE**