
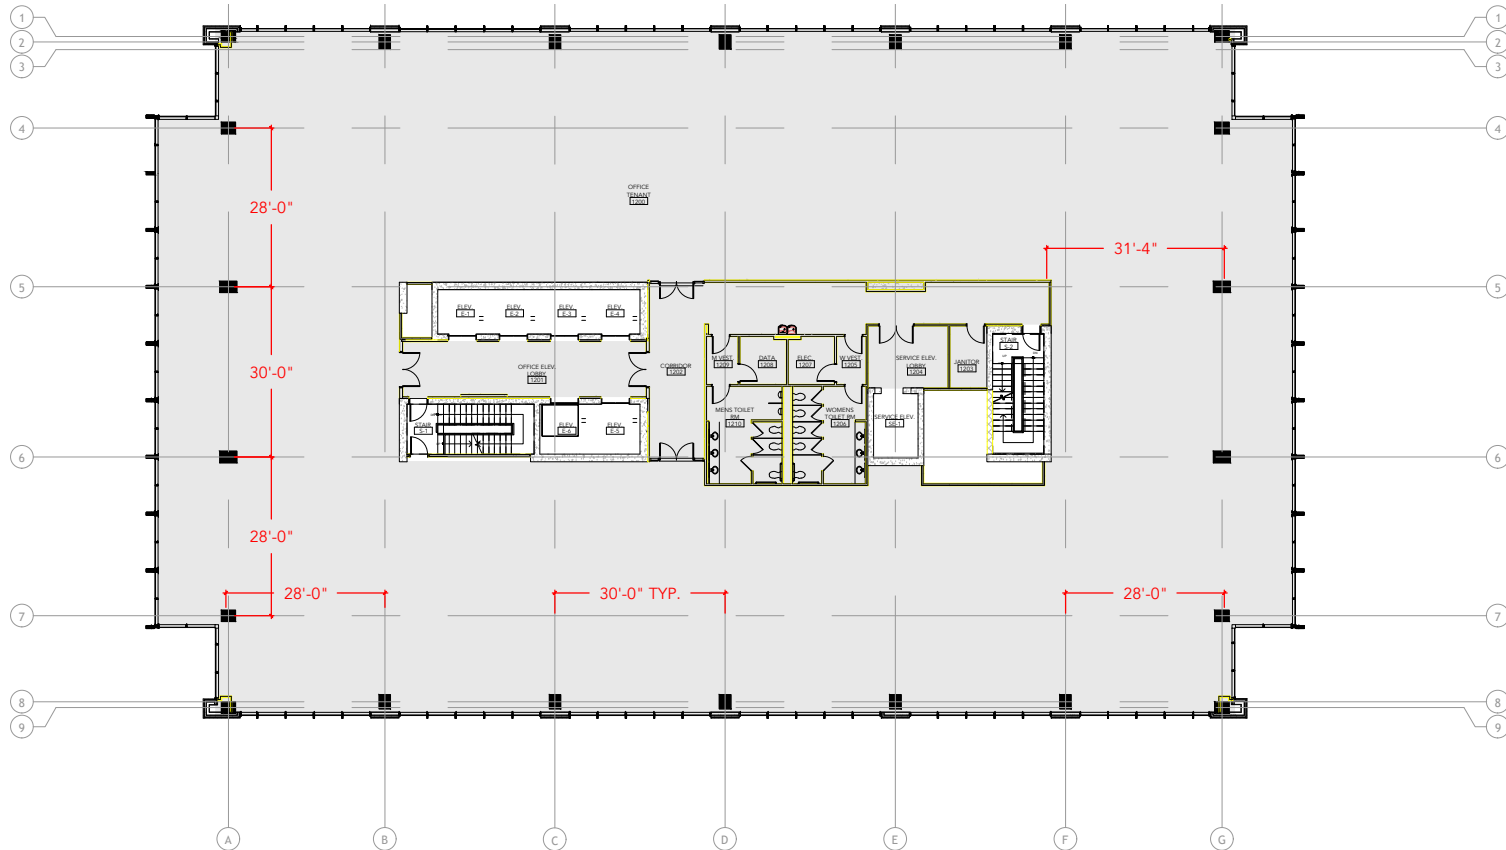


MULTI TENANT 22,128 RSF(12%)
SINGLE FLOOR USER 24,013 RSF(9%)

[Click to access 3D model](#)

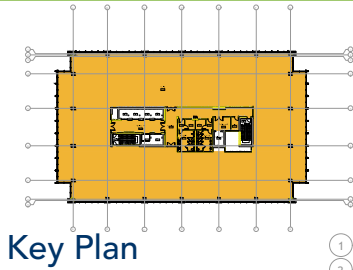

SINGLE FLOOR USER
SUITE TBD (LEVEL 12-18)
LEVEL 12-18
24,013 RSF(9%)

Floor Plan