


Key Plan

MULTI TENANT 18,661 RSF(12%)
SINGLE FLOOR USER 20,640 RSF(9%)

[Click to access 3D model](#)

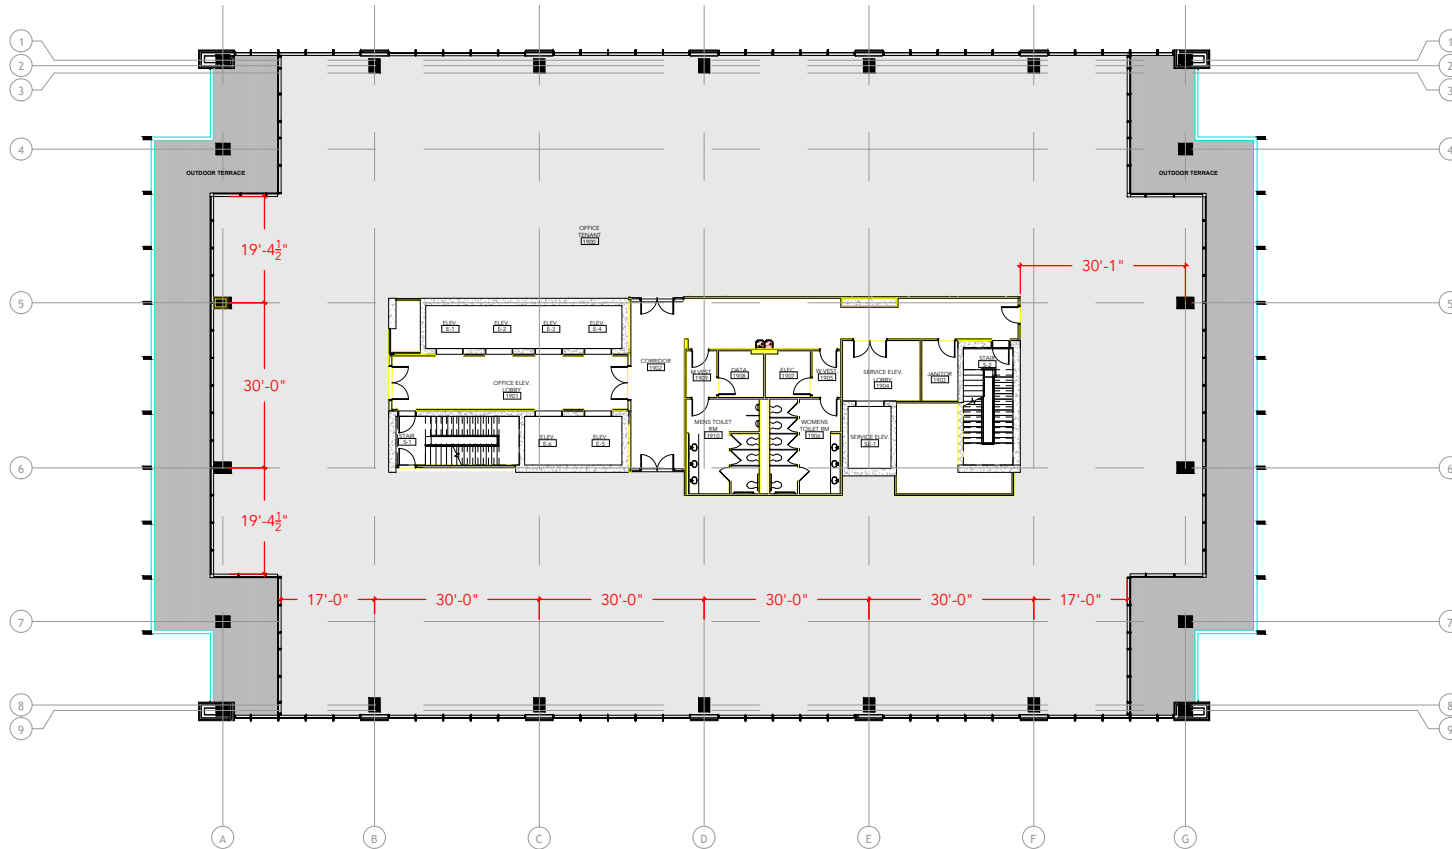

MULTI TENANT
SUITE TBD
LEVEL 19
18,661 RSF(12%)

Floor Plan