


Key Plan

MULTI TENANT 18,668 RSF(12%)
SINGLE FLOOR USER 20,558 RSF(9%)

[Click to access 3D model](#)

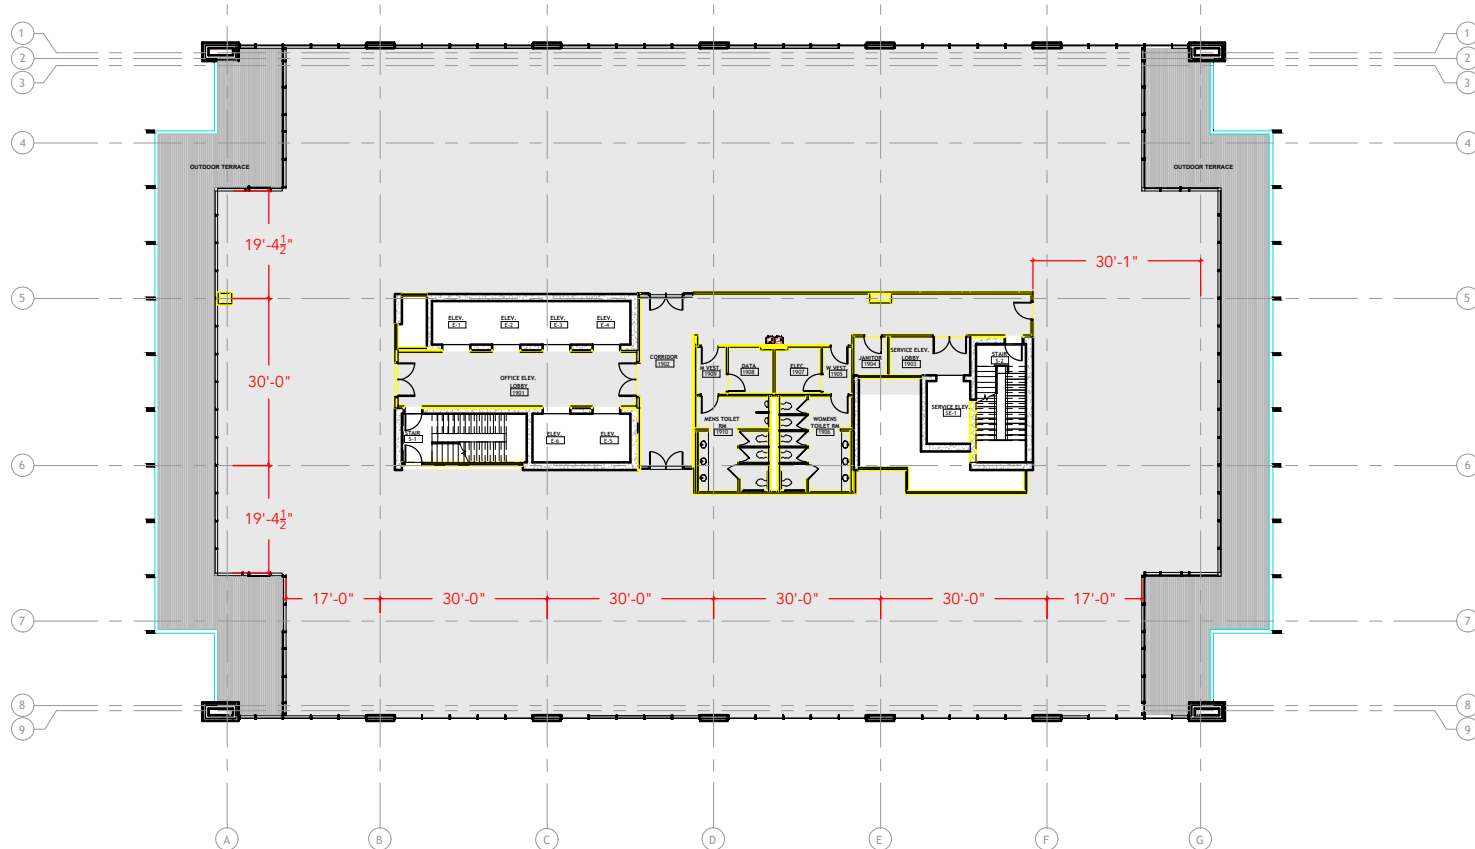

SINGLE FLOOR USER
SUITE TBD
LEVEL 19
20,558 RSF(9%)

Floor Plan