


Key Plan

MULTI TENANT 6,220 RSF(12%)
SINGLE FLOOR USER 8,271 RSF(9%)

[Click to access 3D model](#)

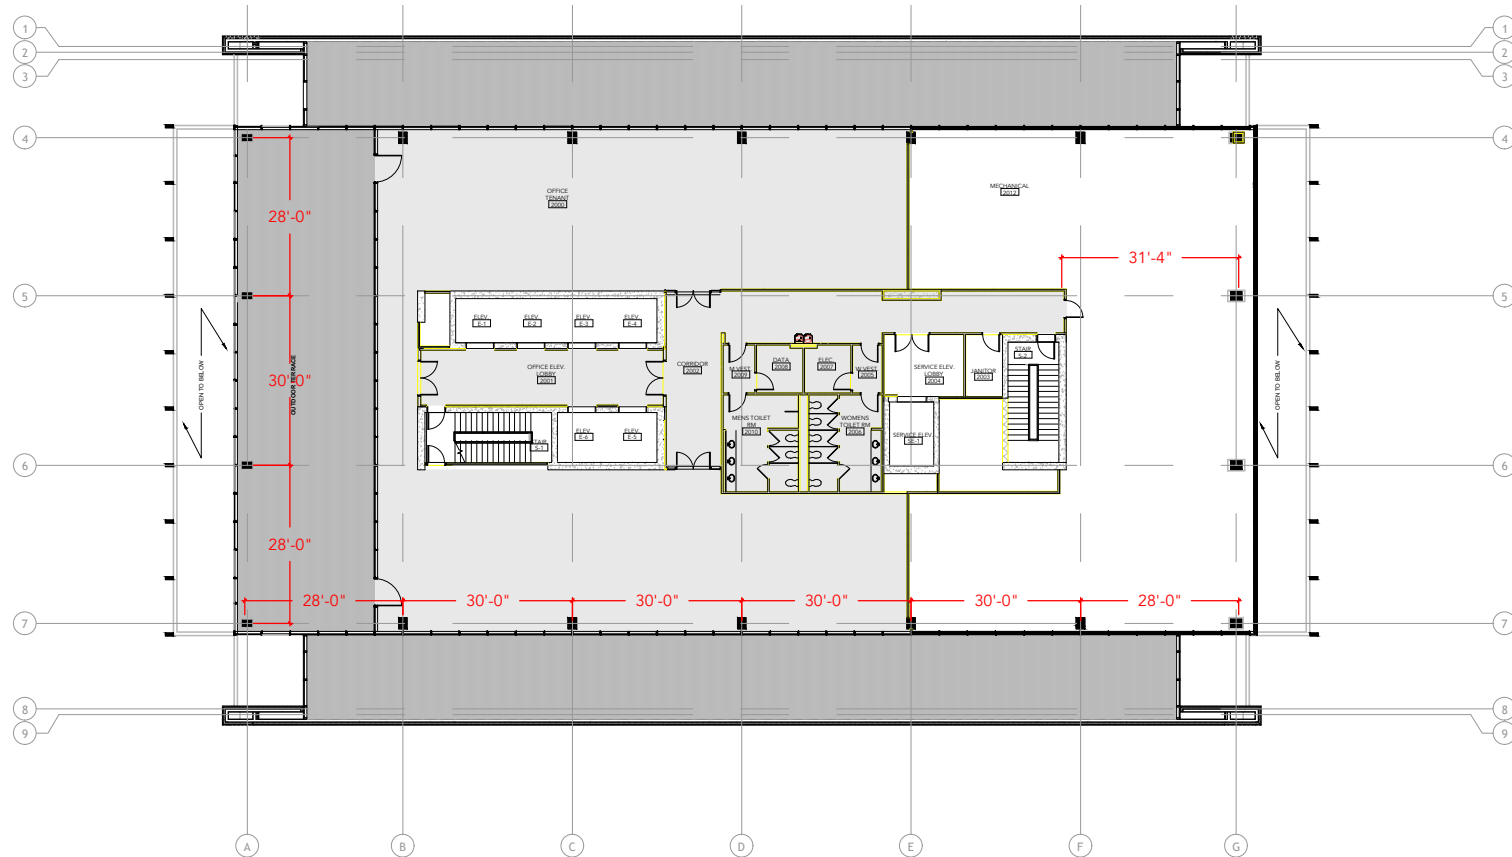

SINGLE FLOOR USER
SUITES TBD
LEVEL 20
8,271 RSF(9%)

Floor Plan