

TOTAL SF AVAILABLE -33,552 RSF

OFFICE - 0,0000 RSF

WAREHOUSE - 33,552 RSF


* INCLUDES % OF METER ROOM

[Click to access CADD file](#)



Key Plan

LOADING

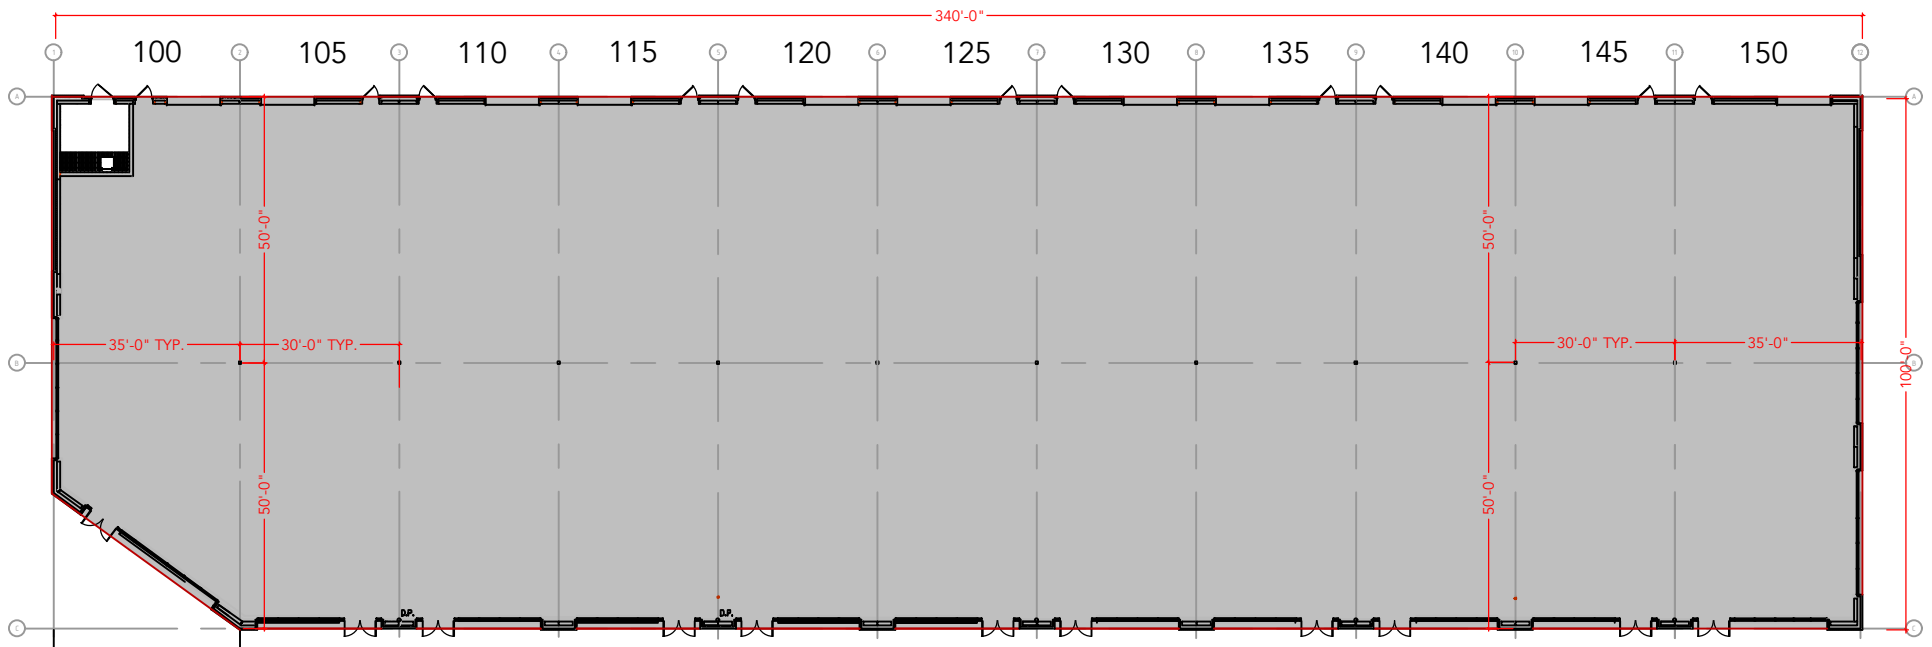

Floor Plan