


TOTAL SF AVAILABLE - 12,917 SF

OFFICE - 7,537 SF  
WAREHOUSE SF - 5,380 SF

[Click to access 3D model](#)

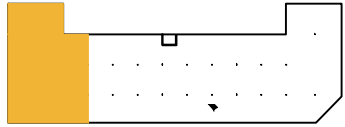

Key Plan

120

110

105

Floor Plan

