


TOTAL SF AVAILABLE - 2,520 RSF

OFFICE - 2,520 RSF

WAREHOUSE - 0,000 SF

* INCLUDED % OF METER ROOM


[Click to access 3D model](#)

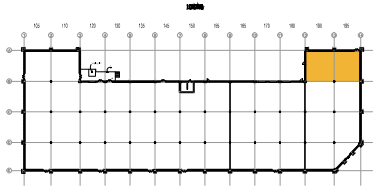

Key Plan

190

195

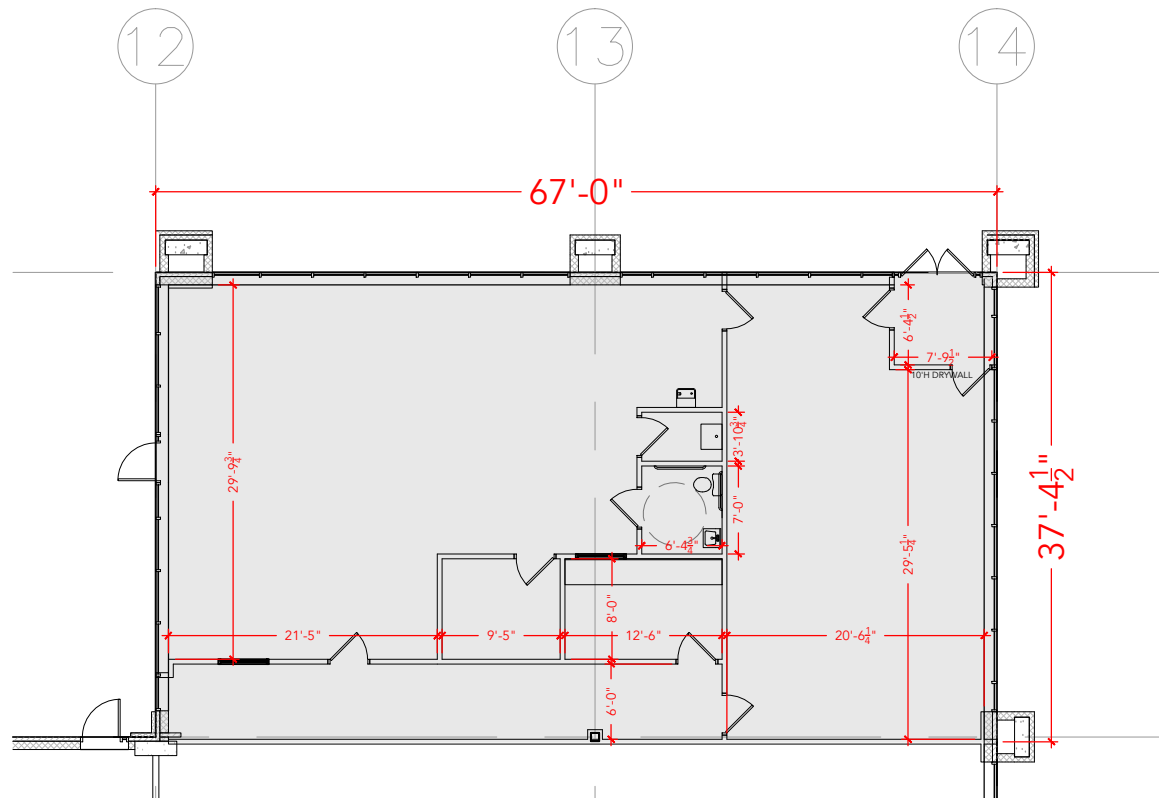

Floor Plan