


**TOTAL SF AVAILABLE - 27,413 RSF**


**OFFICE - 15,598 RSF**

**WAREHOUSE SF - 11,815 RSF**

[Click to access 3D model](#)

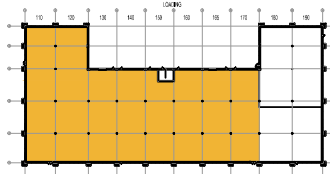

Key Plan

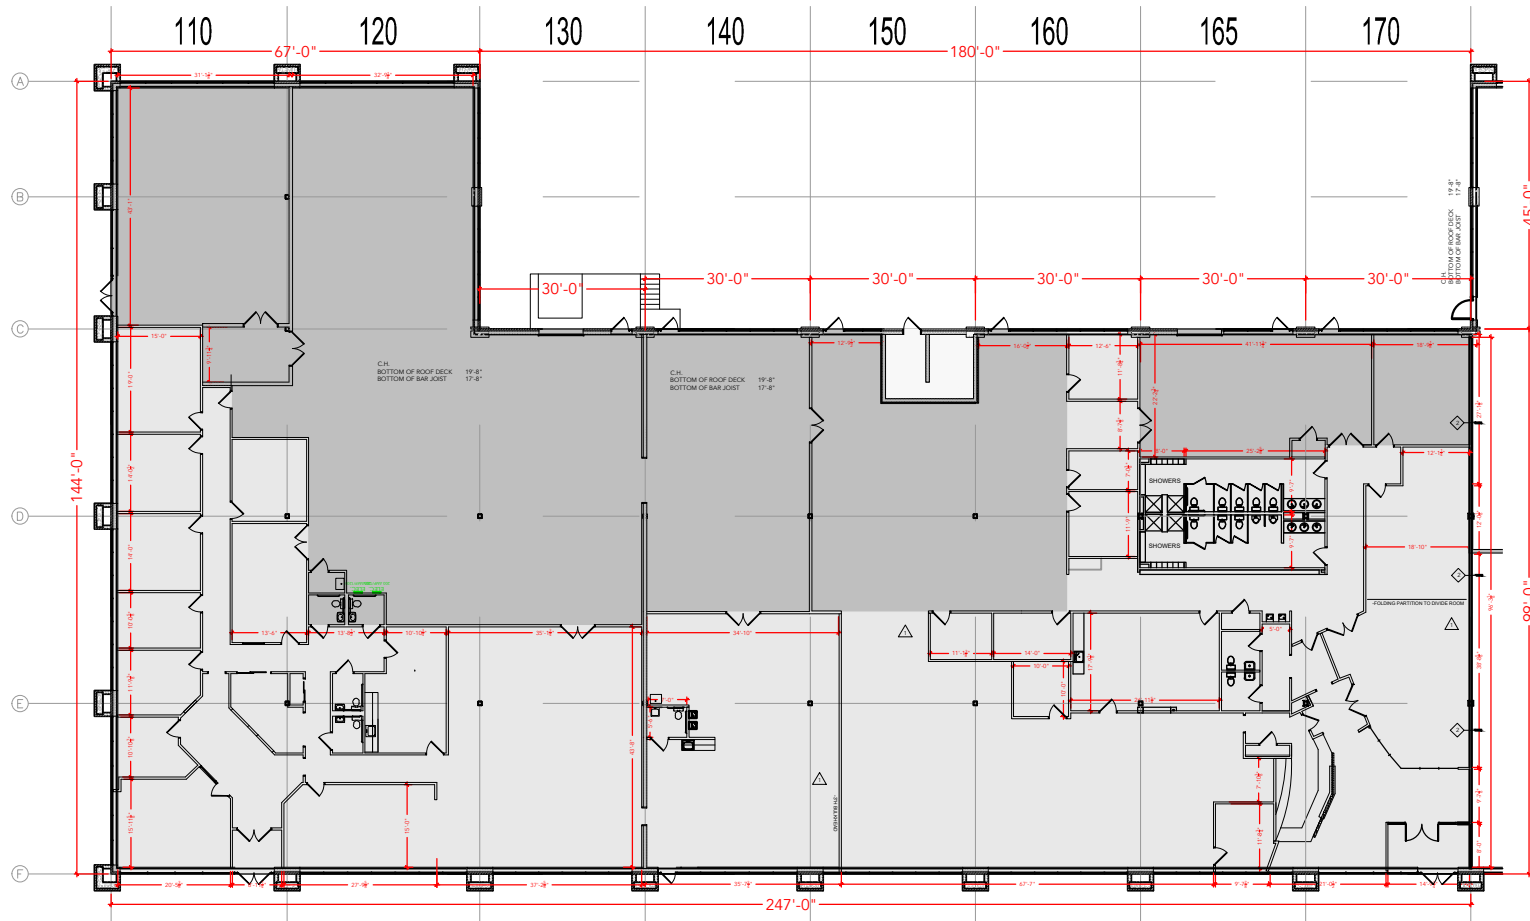

Suite 110-140  
15,929 RSF

Suite 150-170  
11,484 RSF

## Floor Plan